


T.8N. R.3W. W.M.

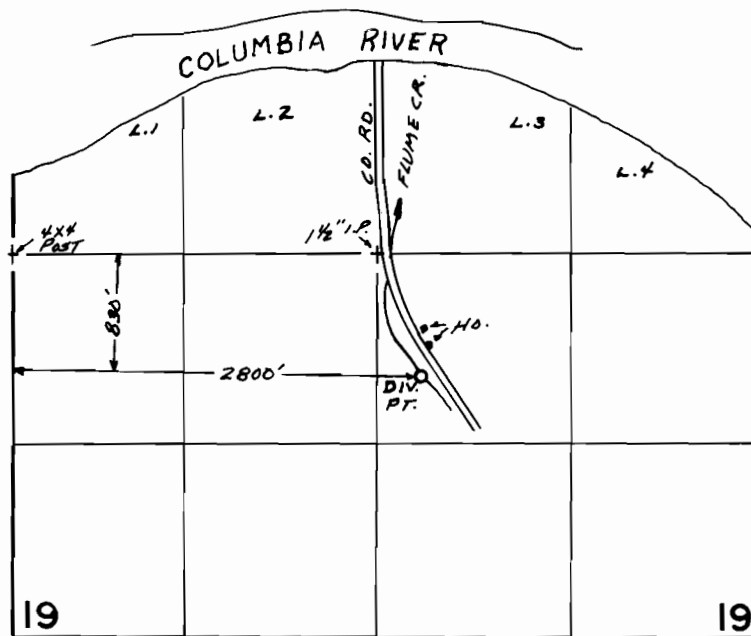

**FINAL PROOF SURVEY**  
UNDER

Application No. 51267... Permit No. 38716...  
IN NAME OF

HAROLD VIUHKOLA

Surveyed June 8 1976, by L.H. NUNN