


T.7 N. R.5 W. W. M.

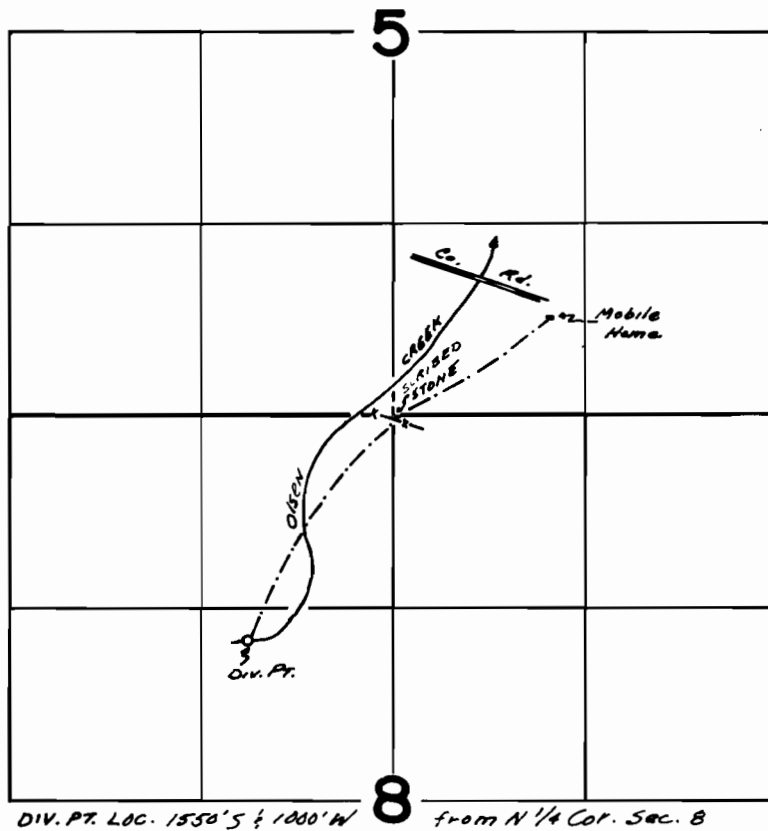

FINAL PROOF SURVEY
UNDER

Application No. ...52104. Permit No. ...37.84.0
IN NAME OF

THURLOW E. HANSON

Surveyed Aug. 19. 1977, by S.C. BROWN.....