


T. 26 S., R. 12 W., W.M.

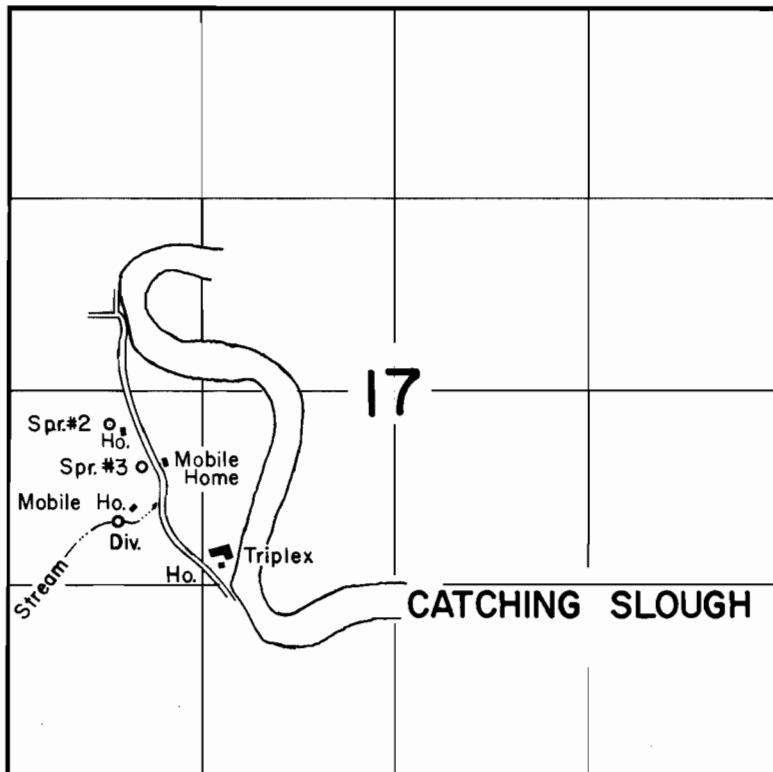

DIV. PTS. LOC.: SPRING NO.2, 240' S. & 700' E.; SPRING NO.3, 530' S. & 920' E.; STEAM, 910' S. & 760' E., ALL FROM W 1/4 COR. SEC.17

**FINAL PROOF SURVEY**  
UNDER

Application No. 49208 Permit No. 36887  
IN NAME OF

LOTTIE R. MARCINO IRVINE

Surveyed May 27, 1976, by L. TOLL