


TOWNSHIP 1 N., RANGE 20 E

4

3

9

10

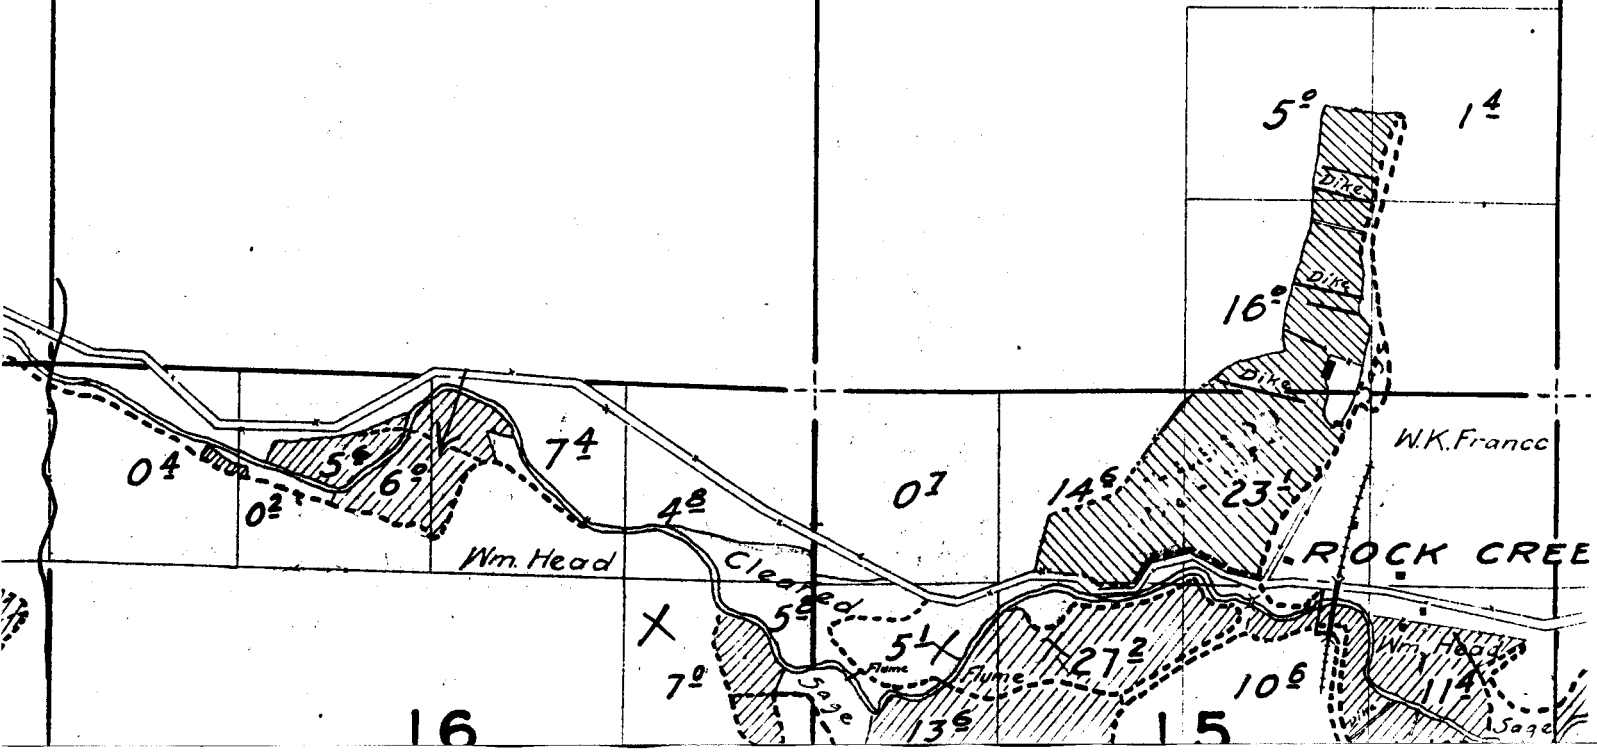

16

15

ANGE 20 E.

4-2-1

3


2


1

10

11

12

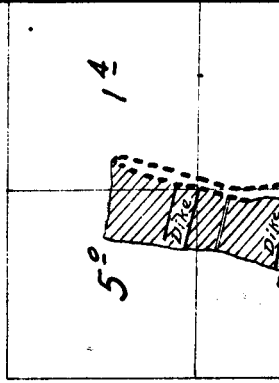

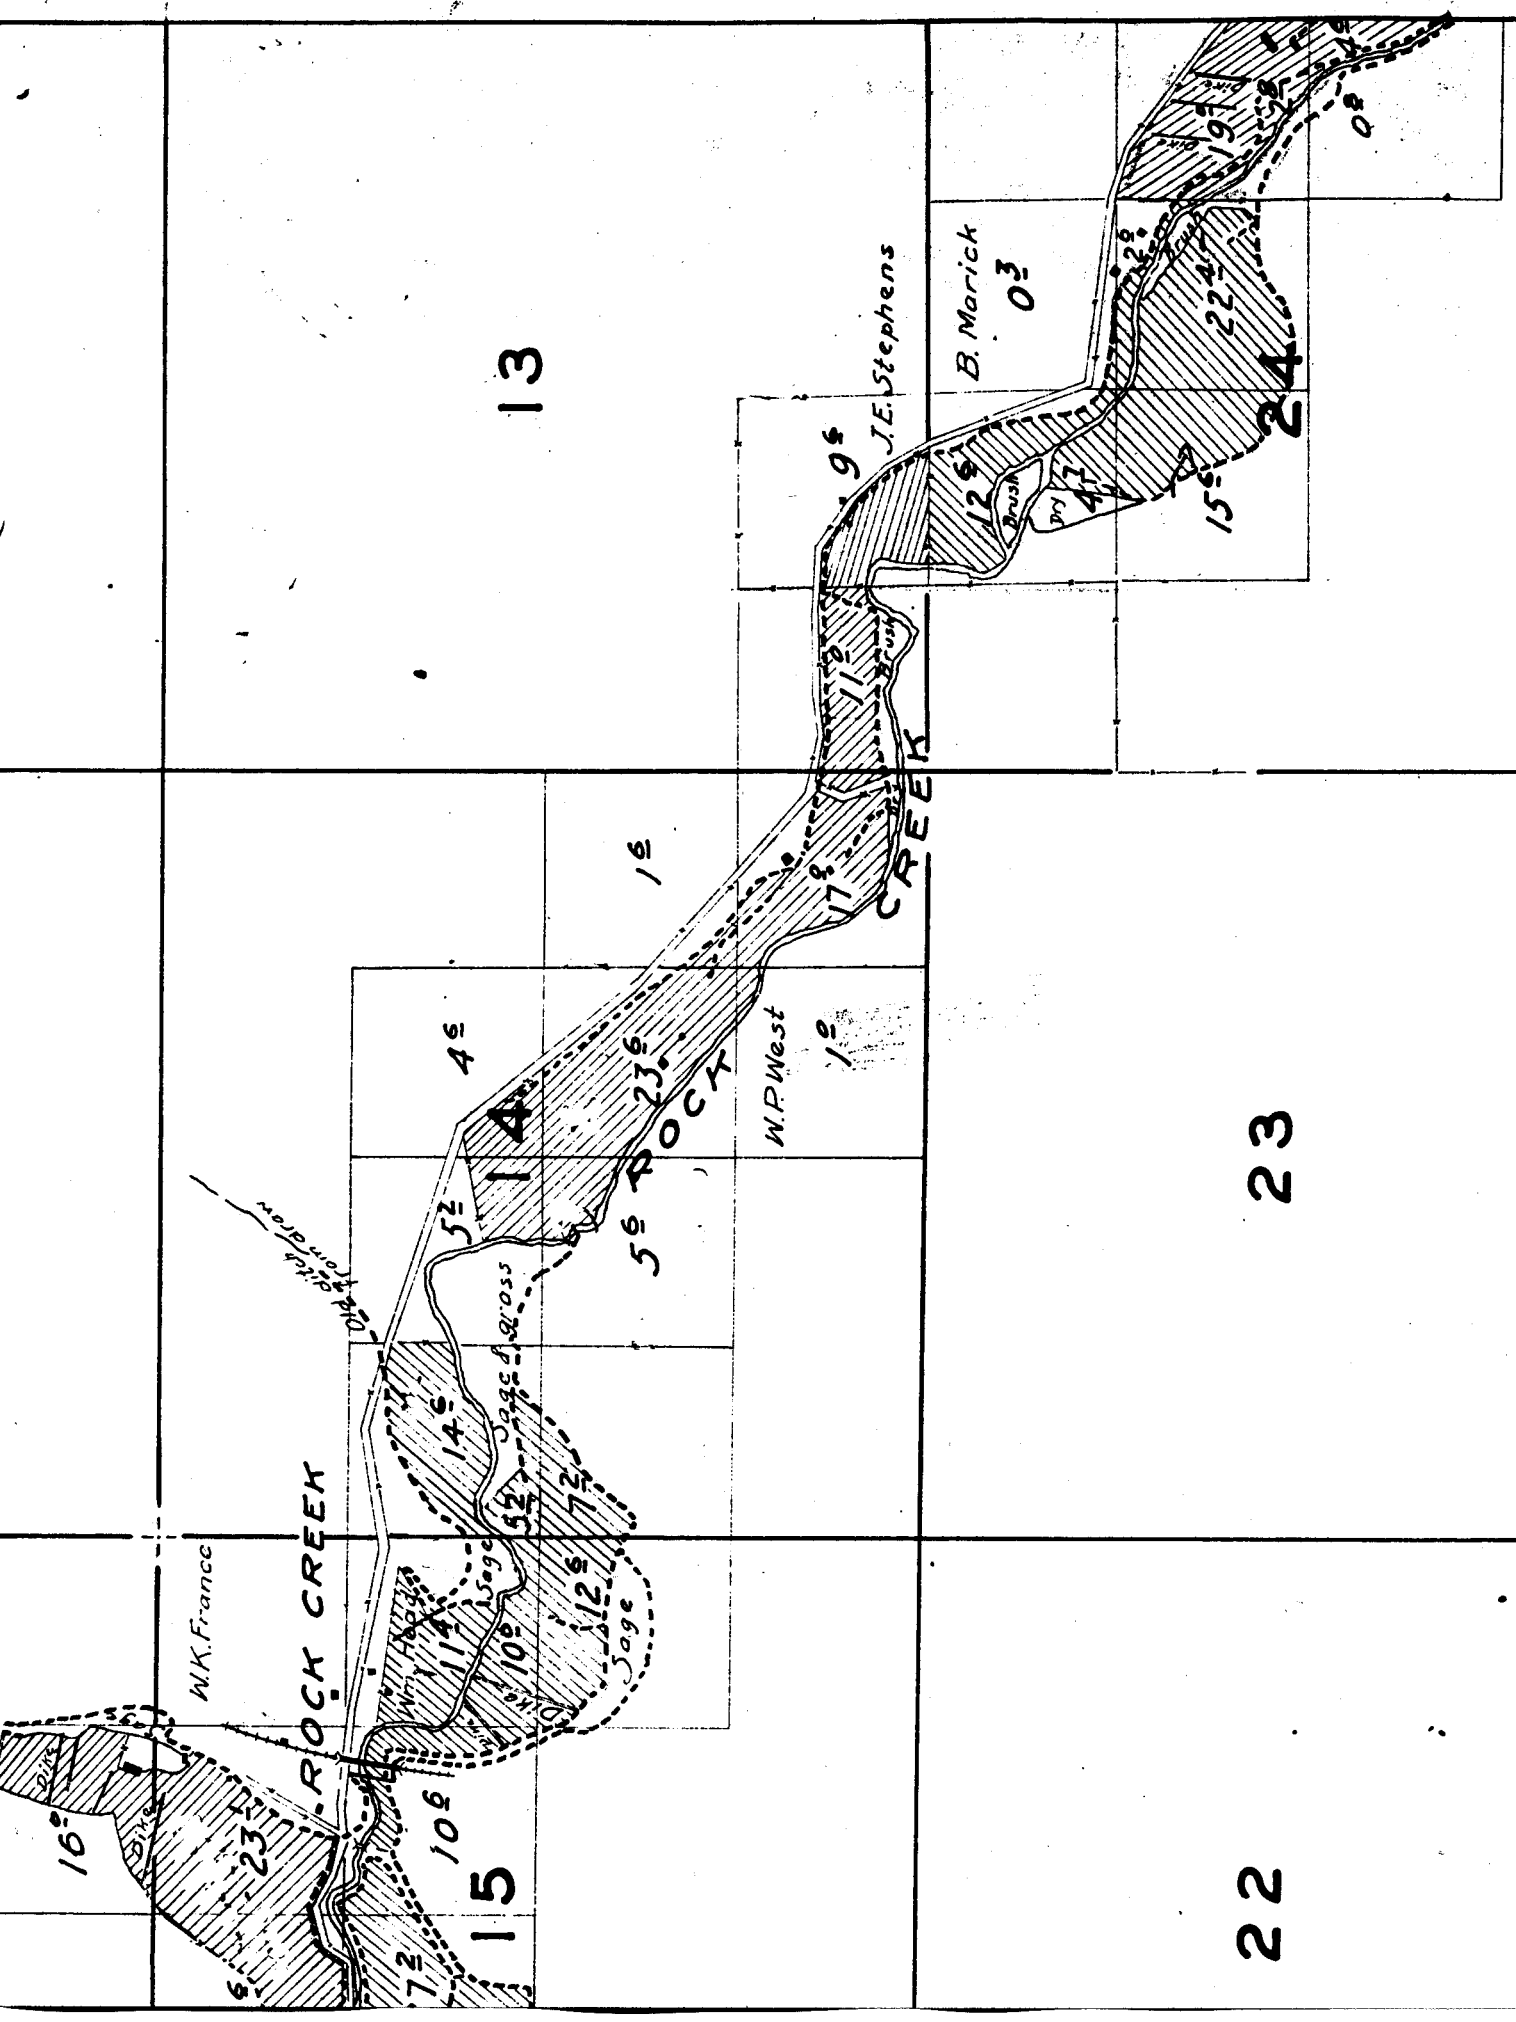

13

J.E. Stephens

B. Marick

03

9s

12s

19s

22s





















4s

14

1s

23s

5s

52s

10s

11s

W.P. West

1s


W.K. France

ROCK CREEK


15

23


22

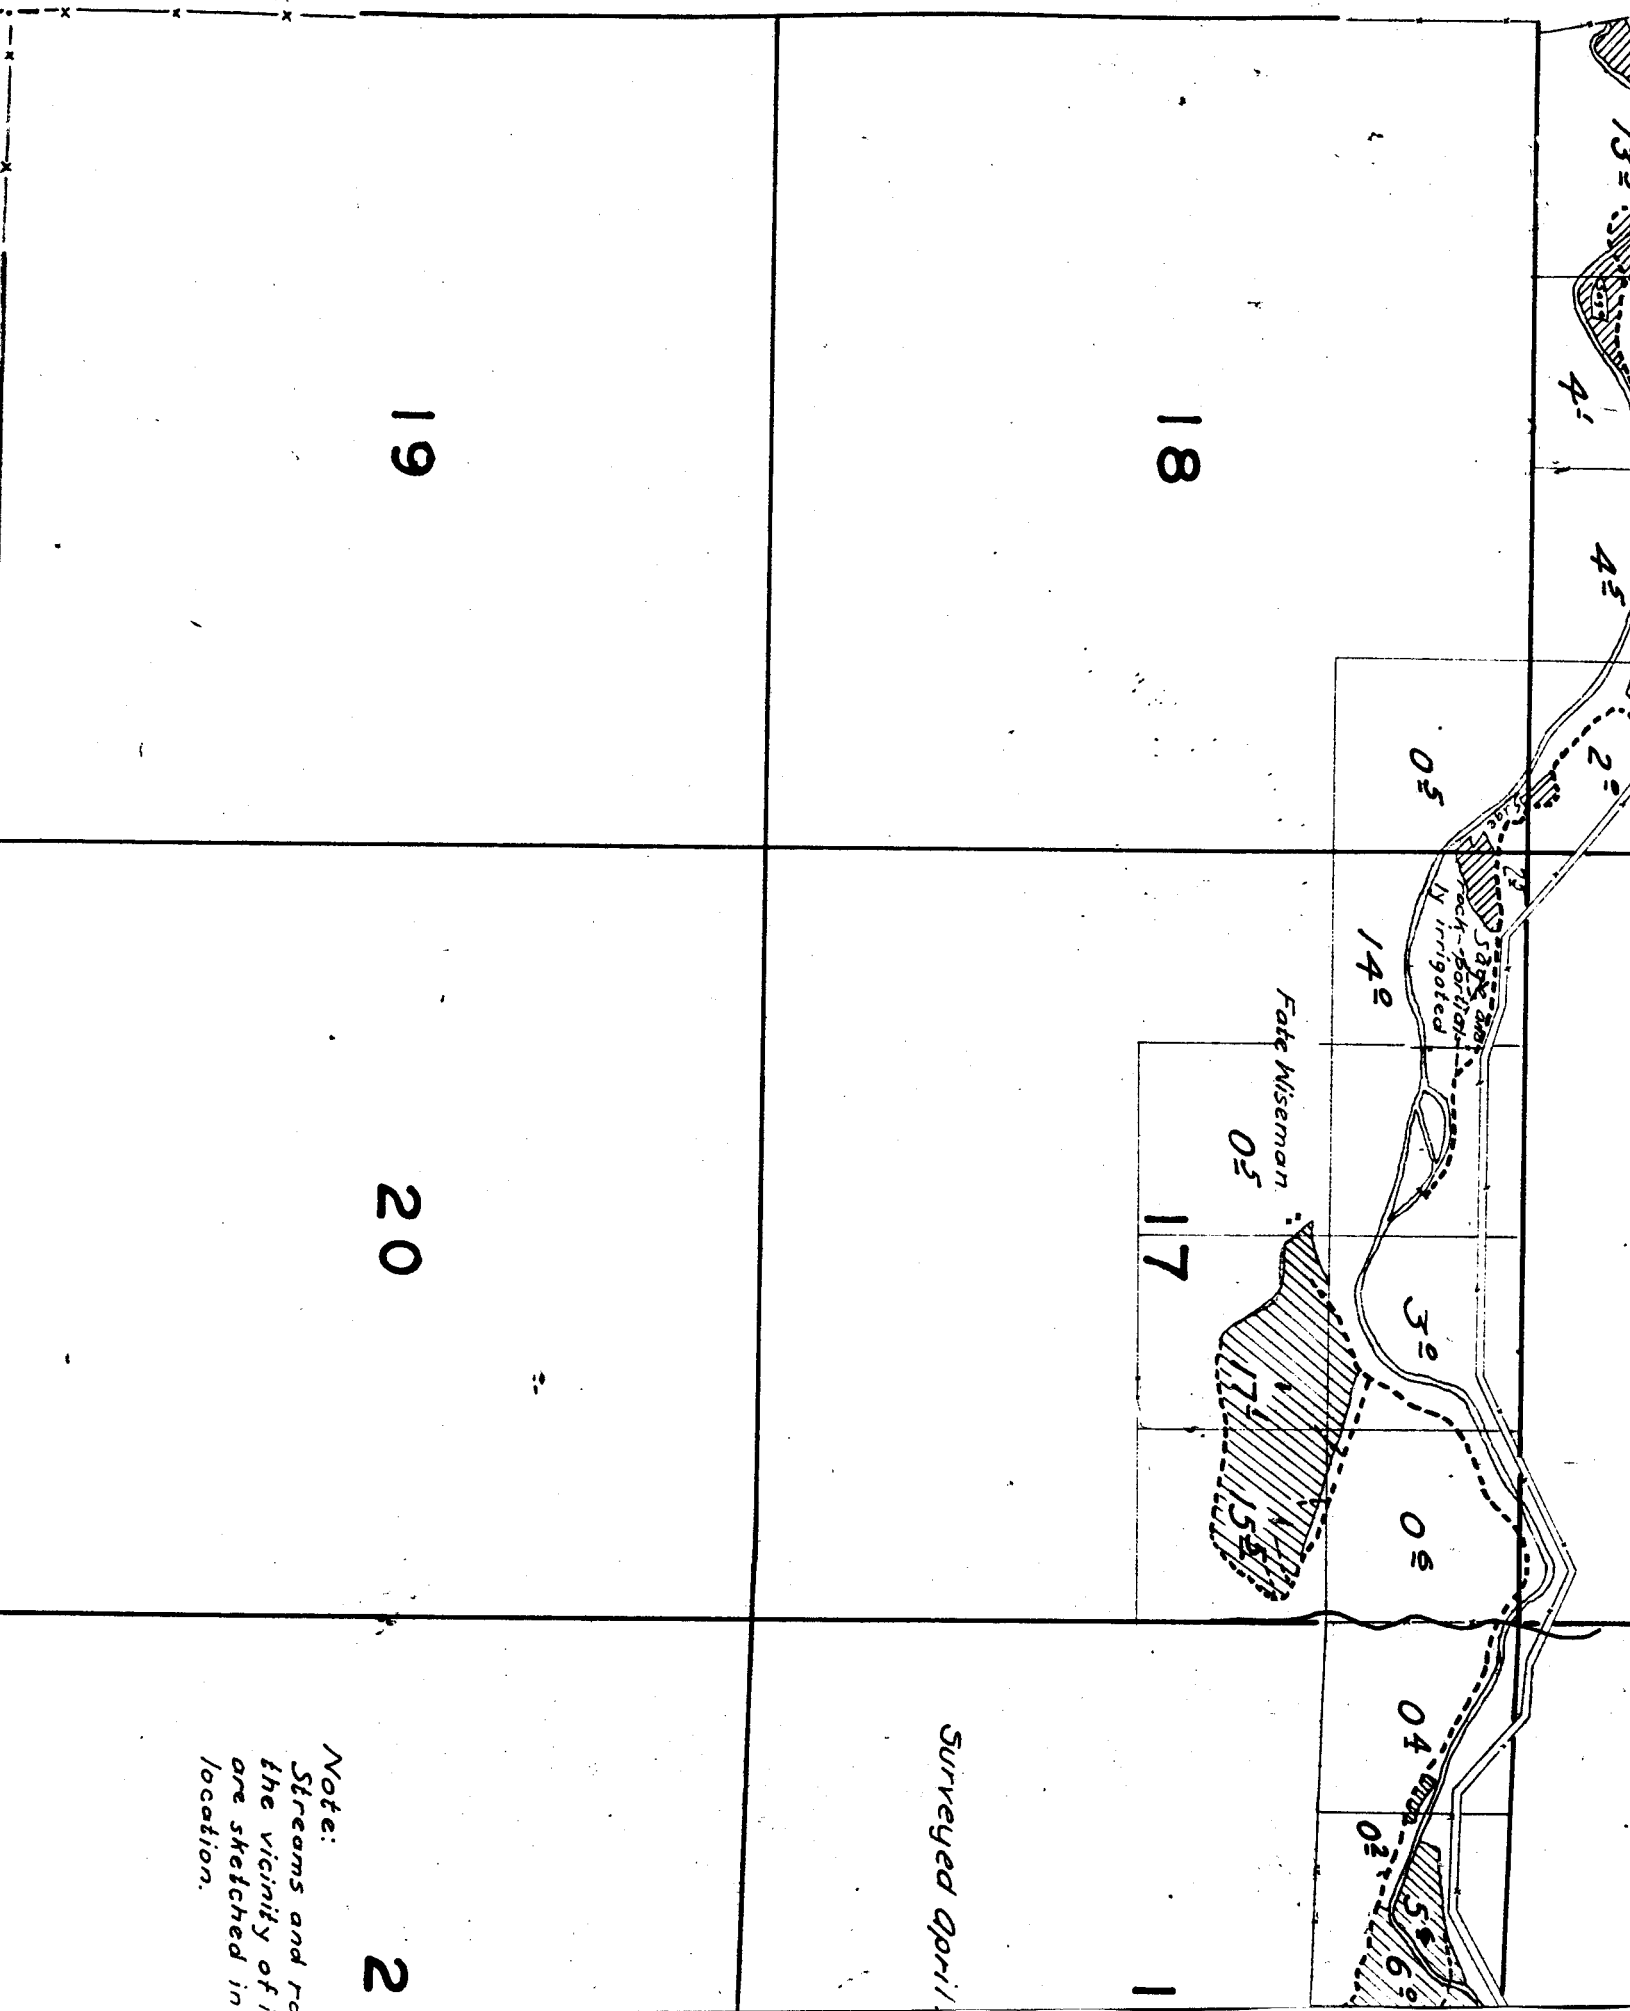

TOWNS

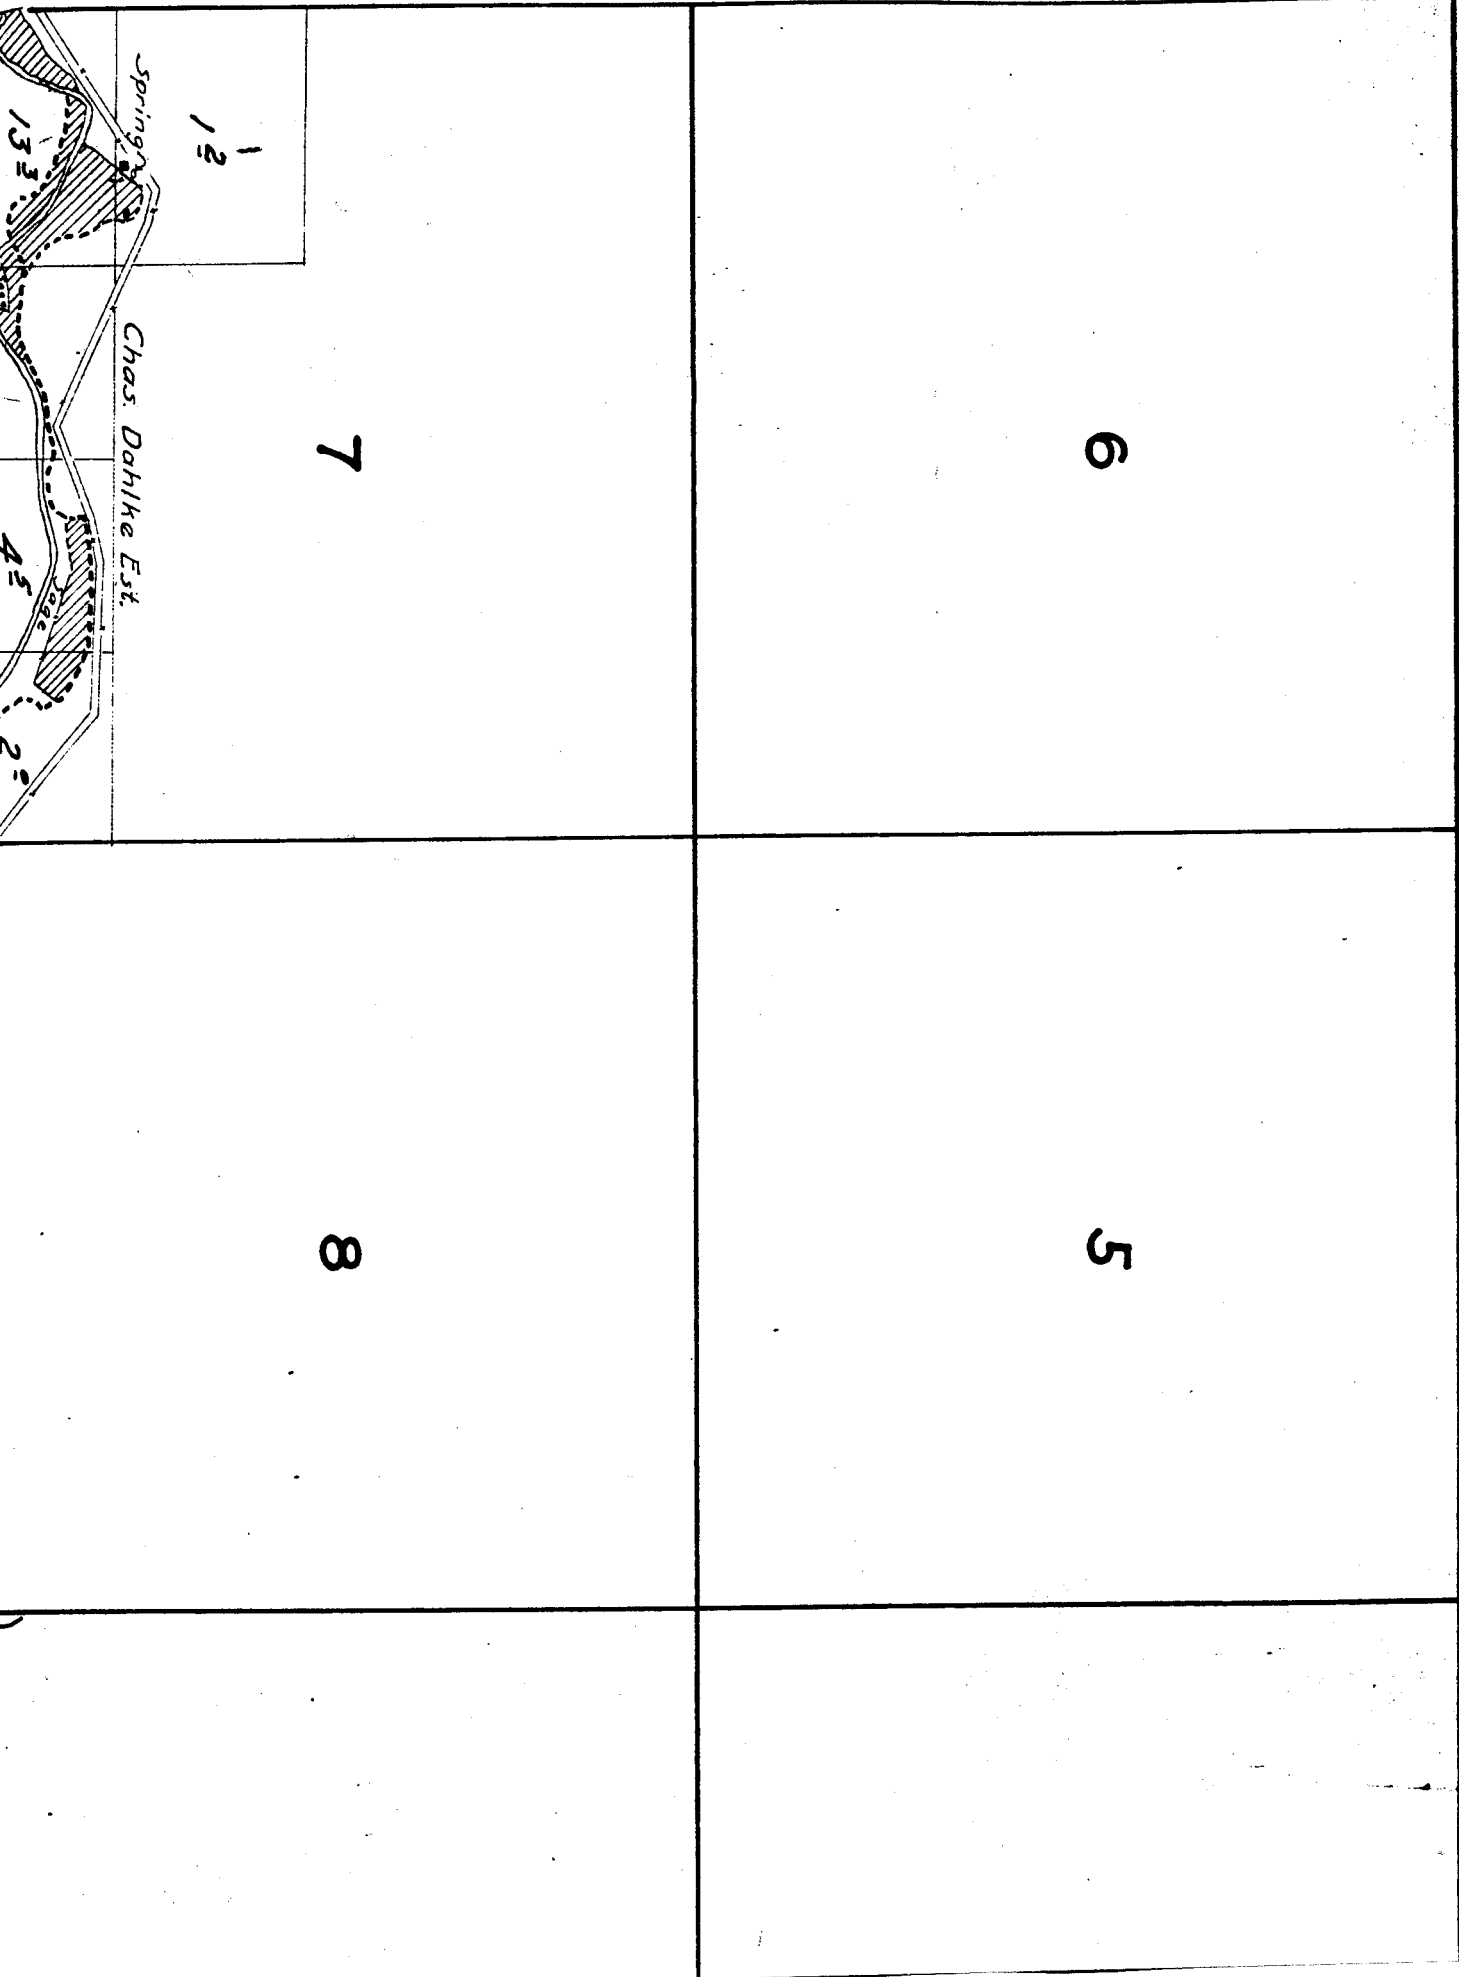

23

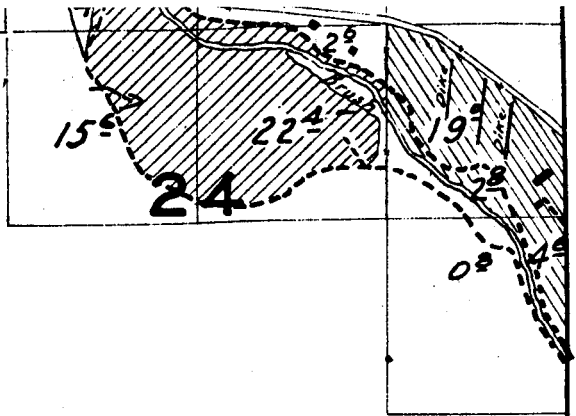

26

25



35

36

19

20


30

29

102
old ditches
JOHN DAY RIVER

31

32

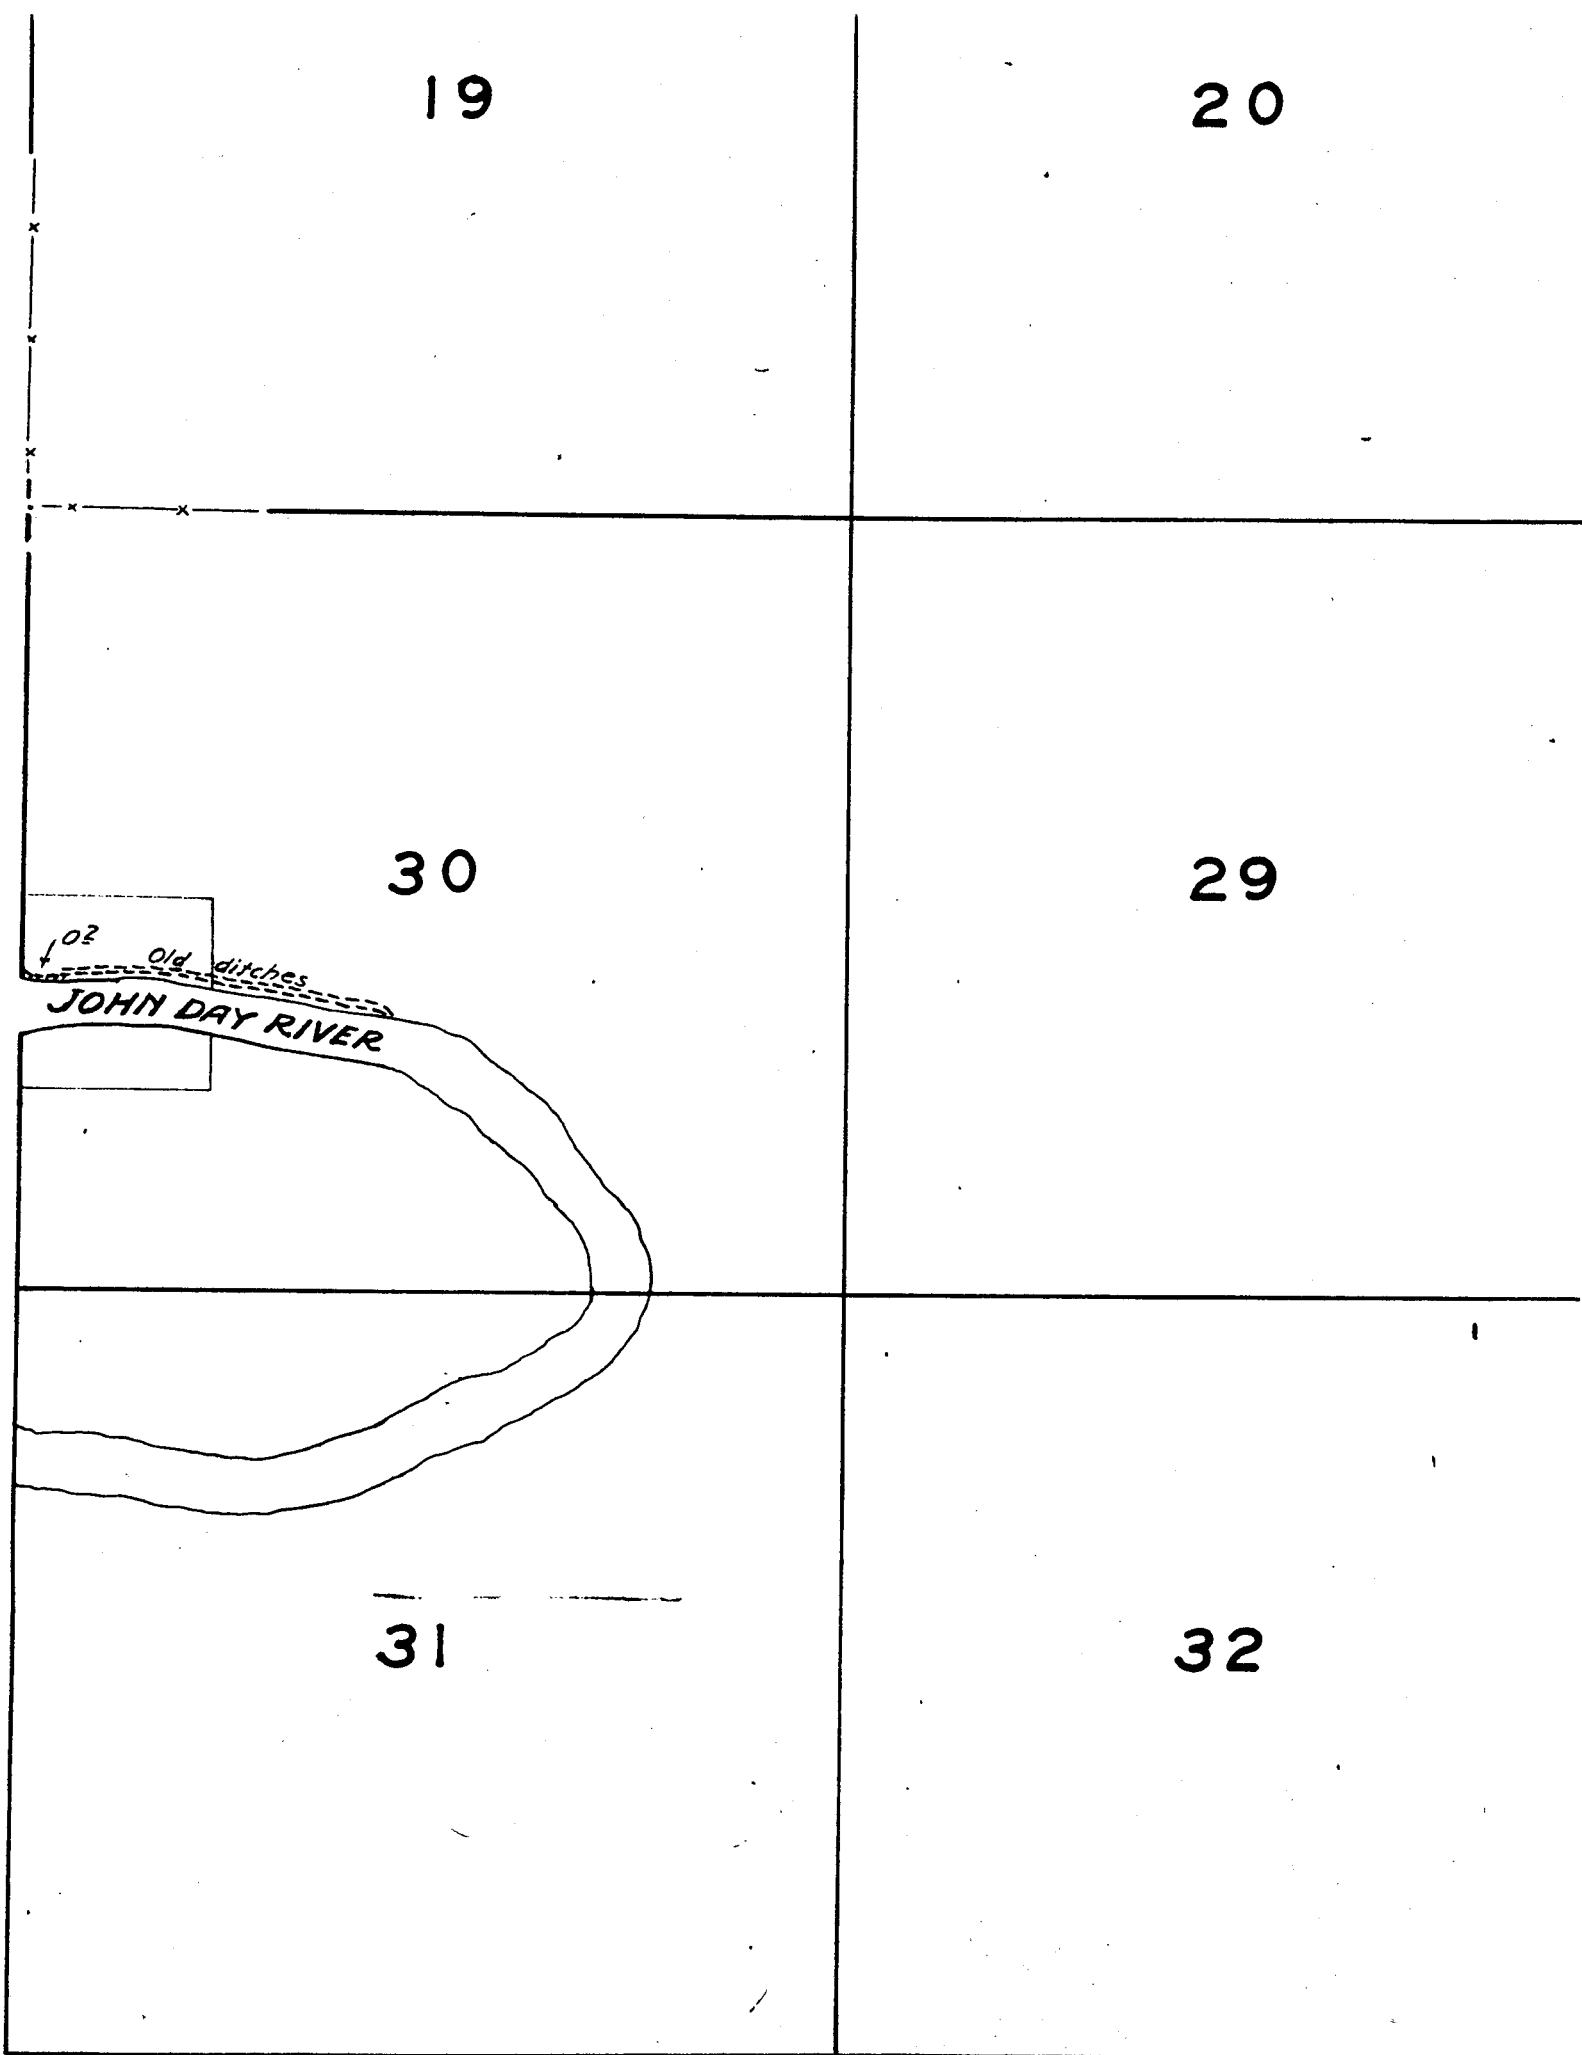


28

27

33

34

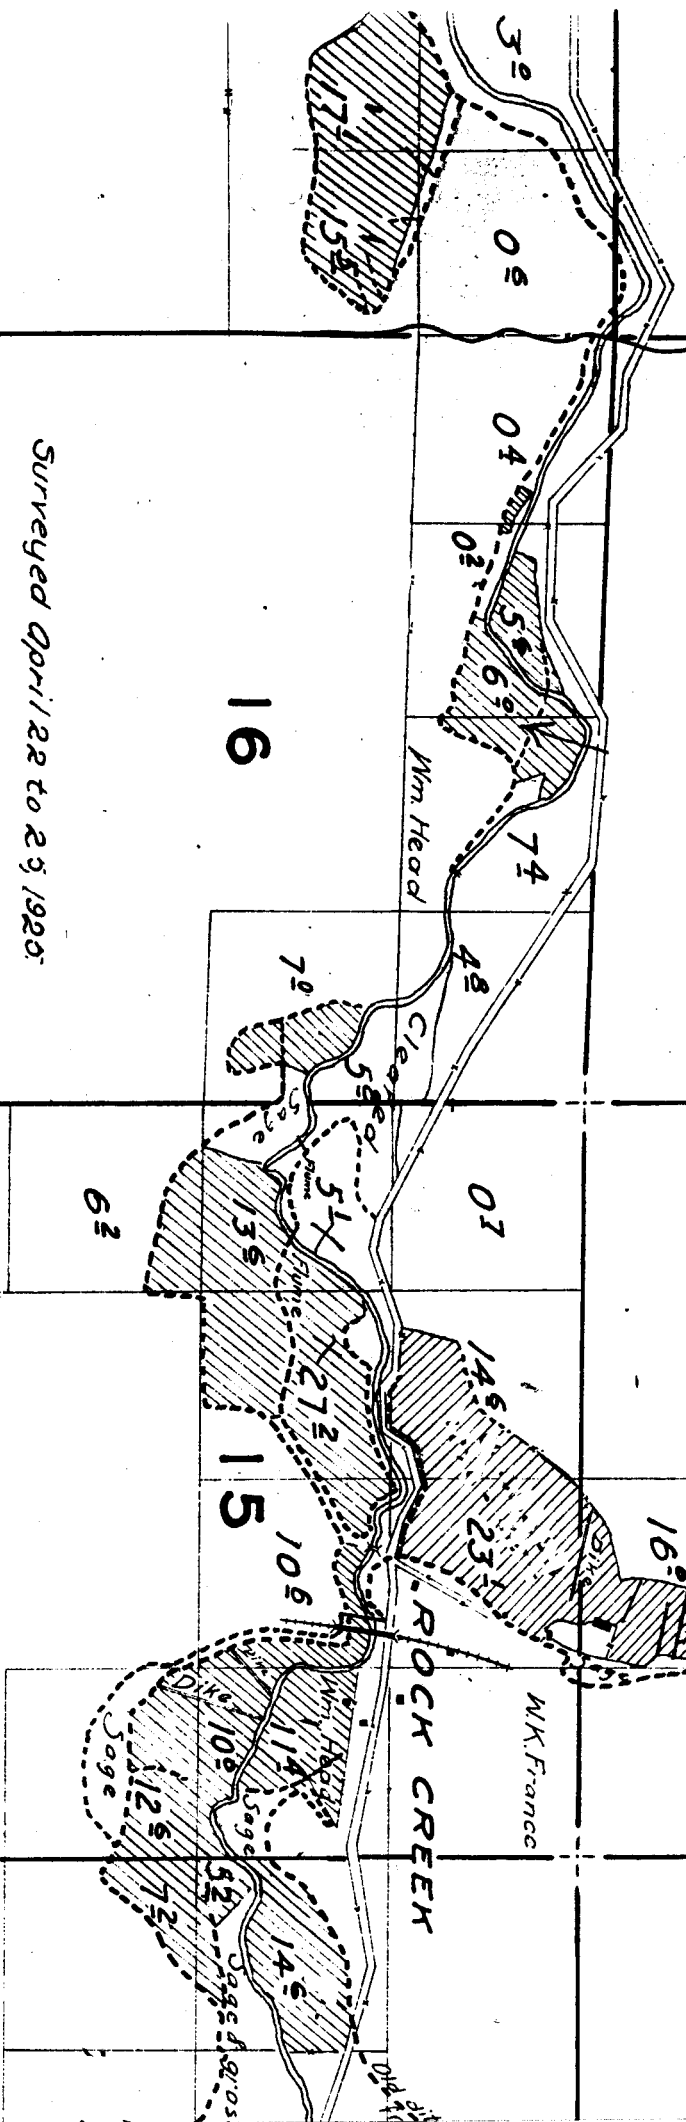

Surveyed April 22 to 25, 1920.

Note:
Streams and roads, except in
the vicinity of irrigated land,
are sketched in approximate
location.

21

22