


T.36S. R.1E. W.M.

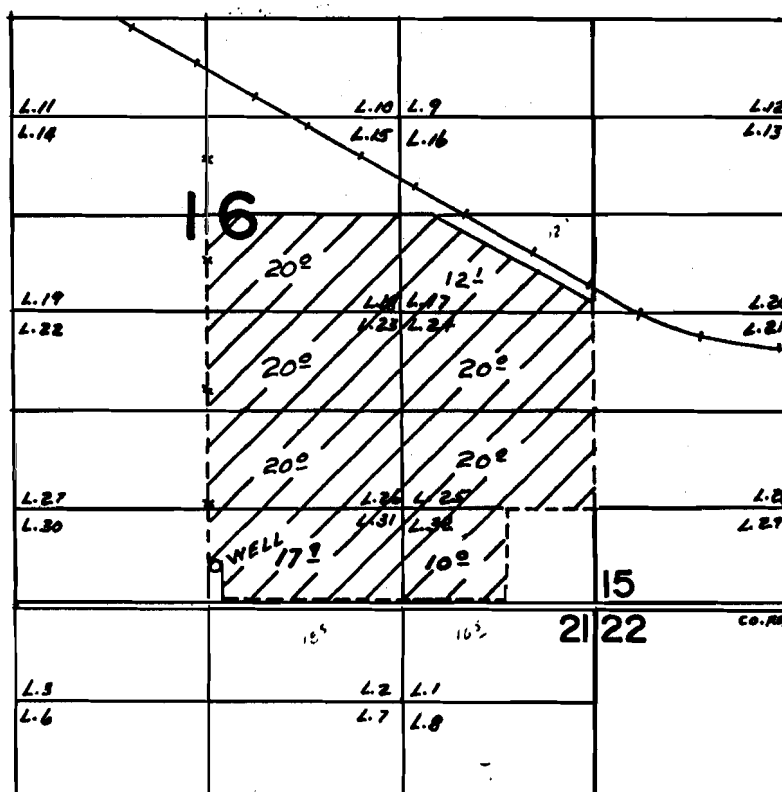

WELL LOC. 280' N. & 50' E FROM S 1/4 COR. SEC. 16

FINAL PROOF SURVEY UNDER

Application No. G-6390. Permit No. G-5981
IN NAME OF

DAVID, JANET & NINA WALTON

Surveyed APR. 24, 1976, by L.H. NUNN