


T.39S.,R.7W.,W.M.

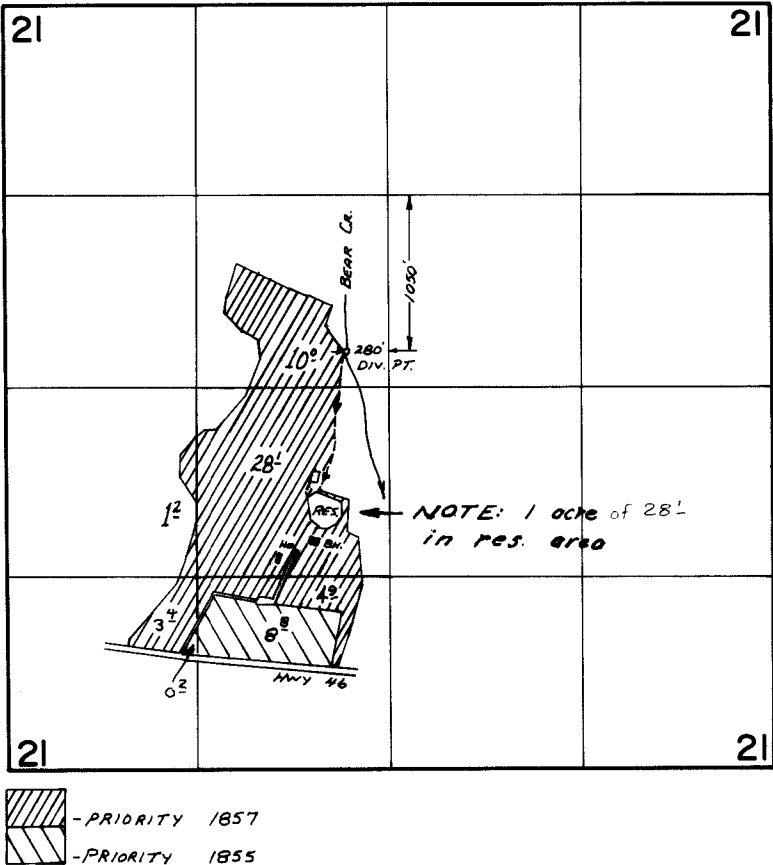

FINAL PROOF SURVEY

UNDER

Transfer No. 2505
Application No. _____ Permit No. _____
IN NAME OF _____

CHARLES W. DAVID

Surveyed MAY 6 1975, by L. Toll
MAY 25, 1977 - REVISED