


T.16S.R.3W.W.M.

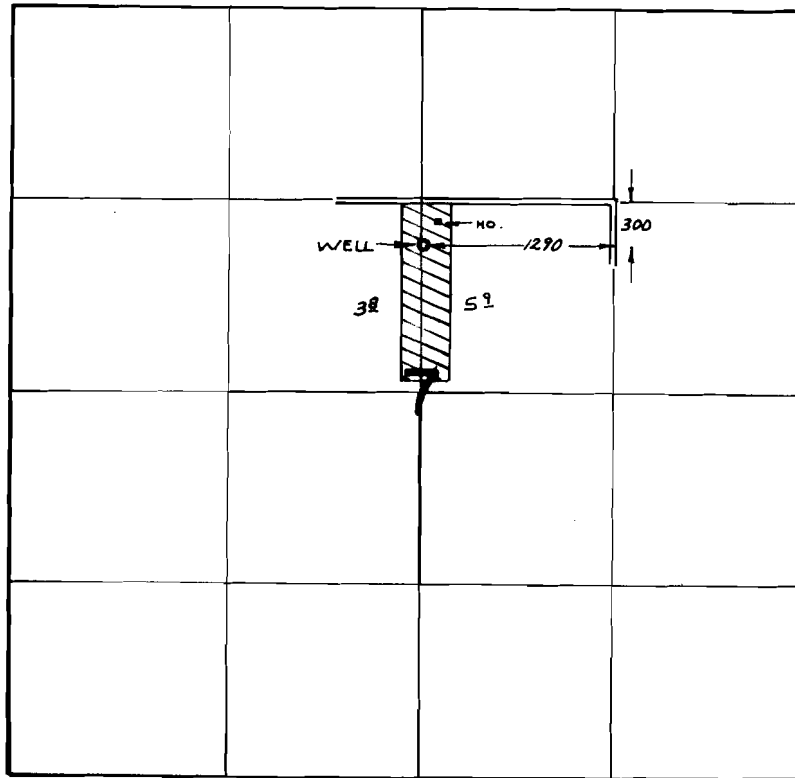

FINAL PROOF SURVEY
UNDER

Application No. G-5150 Permit No. G-4883
IN NAME OF

NORMAN DOUGLAS & JOAN R. CLARK

Surveyed SEPT 6, 1973, by R. MUCKEN