


T.17S. R.7W. W.M.

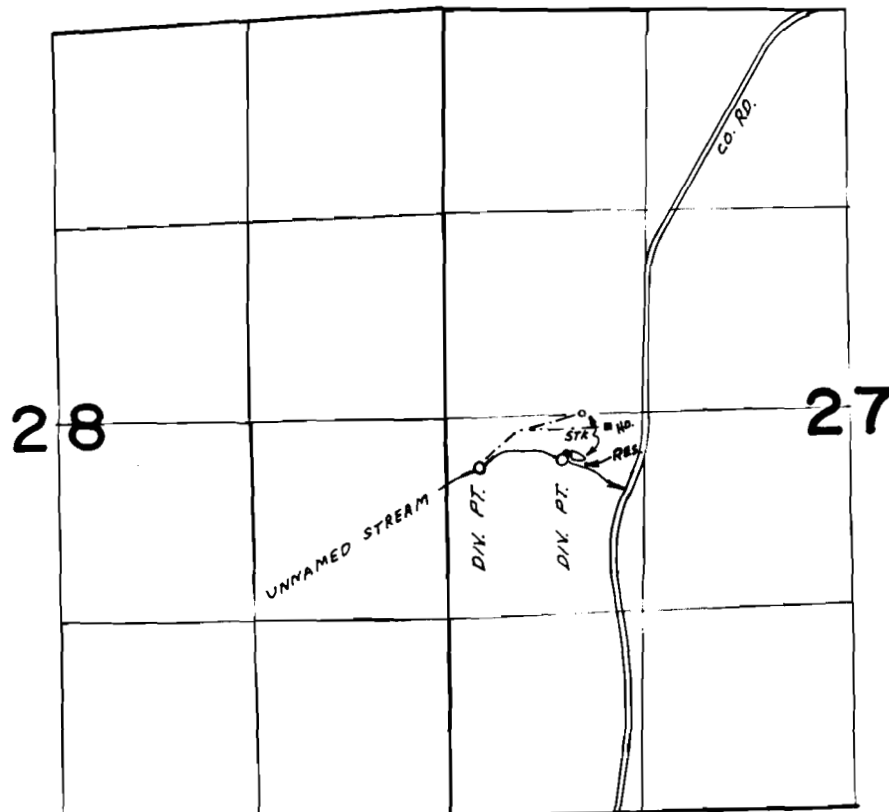

W. DIV. PT. LOC. 340'S. & 220'E.; E. DIV. PT. LOC. 280'S. &
800'E. FROM W 1/4 COR. SE. 27.

FINAL PROOF SURVEY
UNDER

Application No. 45713..... Permit No. 34282....
IN NAME OF

ROBERT E. STRUNK

Surveyed MAY 4.... 1976., by L.H. NUNN.....