


T.16S. R.7W. W.M.

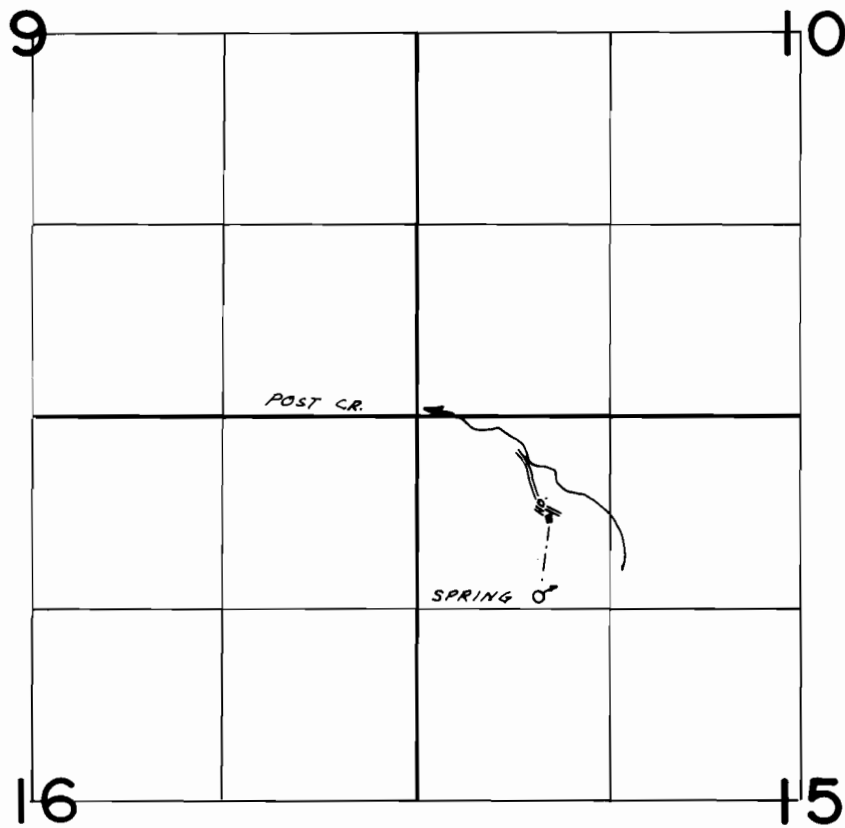

SPRING LOC. 1240'S. & 830'E FROM NW COR. SEC. 15.

FINAL PROOF SURVEY
UNDER

Application No. 51091..... Permit No. 38548....
IN NAME OF

STANLEY JAMES APPLGATE.....

Surveyed MAY 7 1976, by L.H. NUNN.....