T.17S. R.6W. W.M.

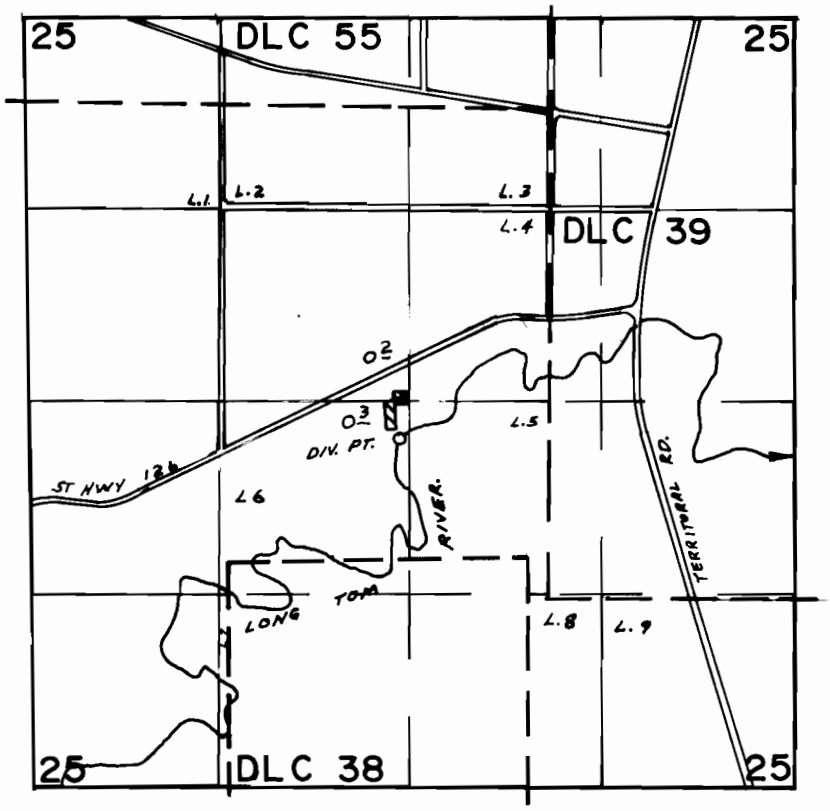

DIV. PT. LOC. 260' S. & 70' W FROM CENTER SEC. 25.

FINAL PROOF SURVEY
UNDER

Application No. 51282 Permit No. 38726
IN NAME OF

ORLAND K. & FLORENCE M. GARNER

Surveyed MAY 7 1976, by L.H. NUNN

DBQ-1JJ-102