


T.13S. R.10W. W.M.

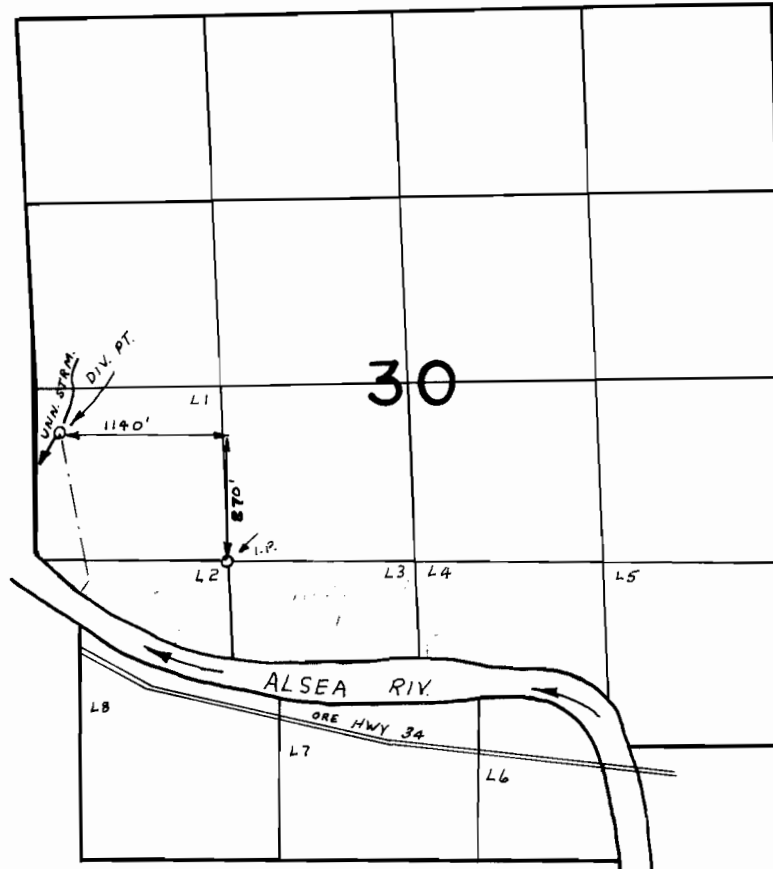

FINAL PROOF SURVEY
UNDER

Application No. 43042 Permit No. 31861
IN NAME OF

BARCLAY MEADOWS WATER IMPROVEMENT CORPORATION

Surveyed JUNE 6, 1974, by L.H. NUNN

Inspection Sept 10, 1975 by L.M. TOLL