


T.I.S. R.IOW. W.M.

SEC. 20

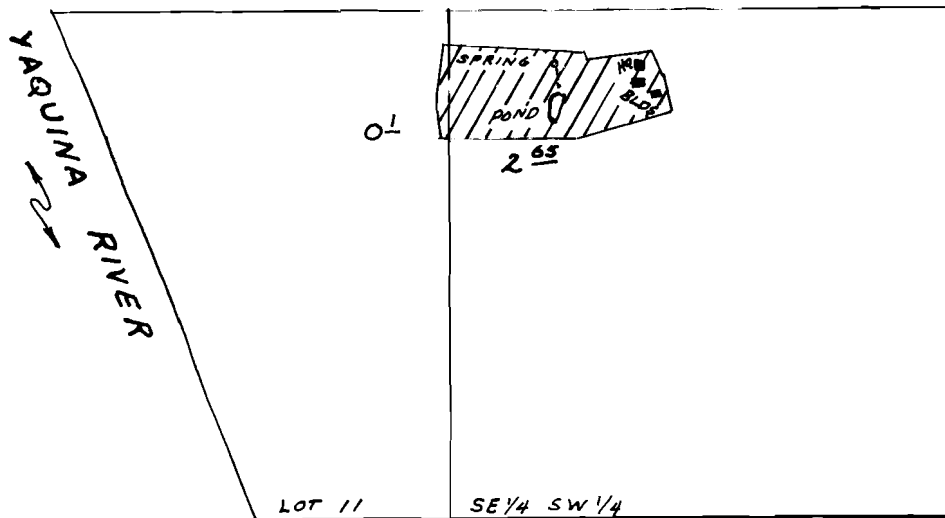

SPRING LOC. 1180' N. & 1040' W. FROM S $\frac{1}{4}$ COR. SEC. 20

SCALE 1" = 500'

FINAL PROOF SURVEY
UNDER

Application No. 49911 Permit No. 37559
IN NAME OF

VIRGIL R. CLABAUGH

Surveyed AUG. 10, 1976, by L.H. NUNN