


# T.6 & 7S. R.10W. W.M.

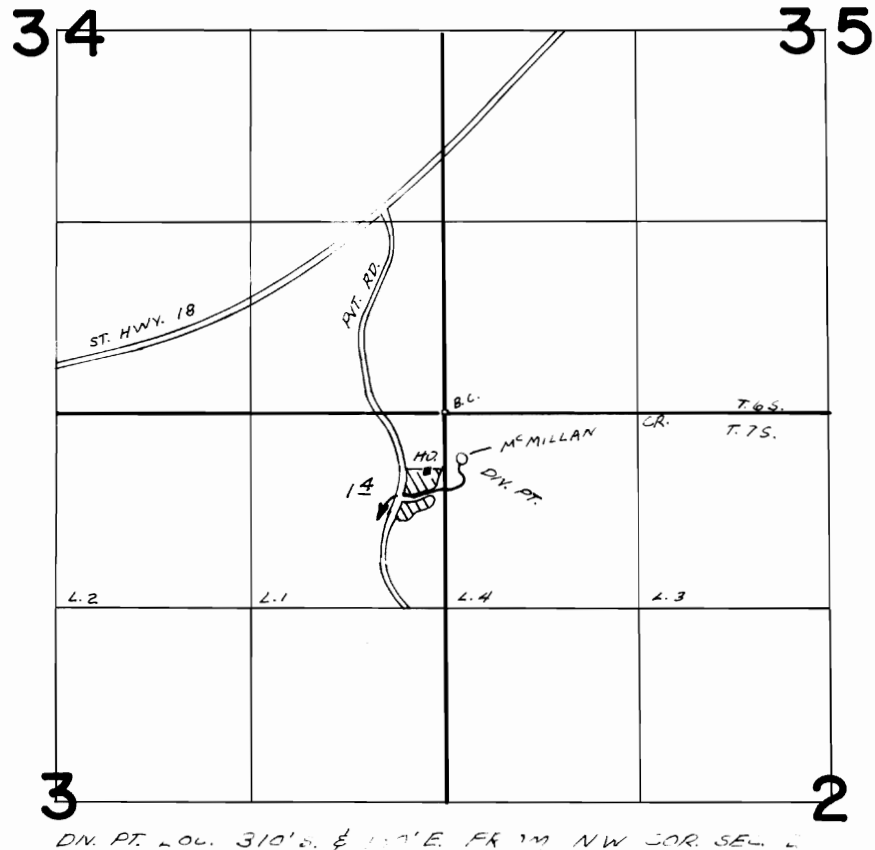

## FINAL PROOF SURVEY UNDER

Application No. 52435... Permit No. 39436...  
IN NAME OF

HOMER McMILLIN

Surveyed AUG. 13. 1976, by L.H. NUNN