


T.10S., R.3 & 4W., W.M.

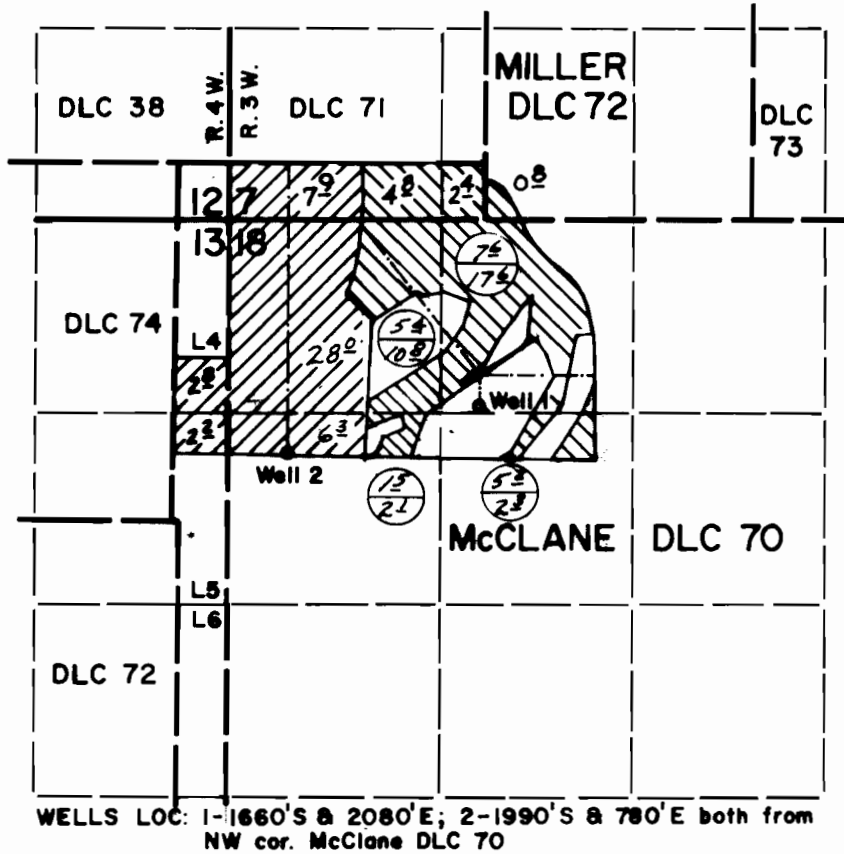

 Well 2

 Well 1

 Old Rights
This Permit

FINAL PROOF SURVEY UNDER

Application No. G-5984 Permit No. G-5050
IN NAME OF

DAVID E. & DARLENE M. CHAMBERS

Surveyed April 15 1976, by D. Norby