


T.11&12S., R.2W., W.M.

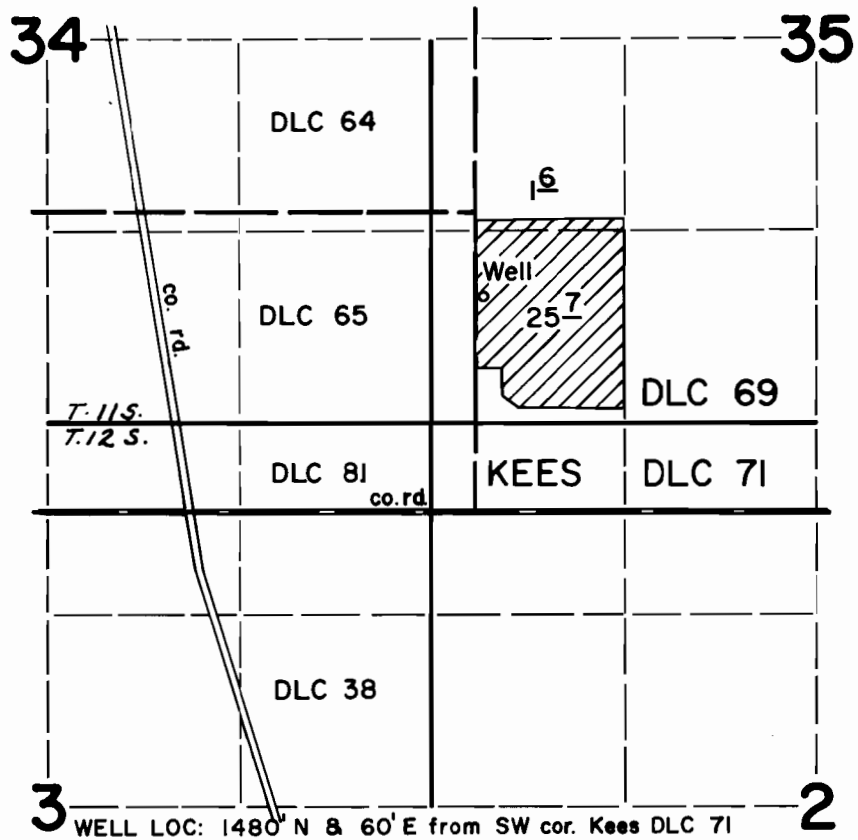

FINAL PROOF SURVEY UNDER

Application No. G-6763 Permit No. G-6283
IN NAME OF

VERNON DEE CARTER

Surveyed April 14 1976, by D. Norby