


T.13S., R.3W., W.M.

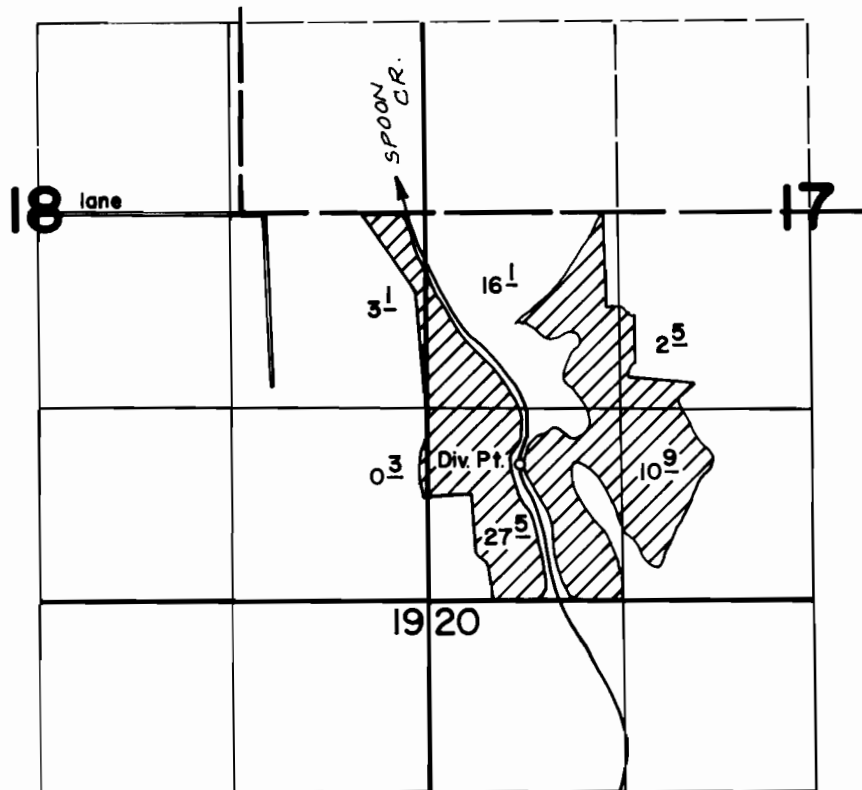

DIV. PT. LOC: 930' N & 630' E from SW cor. sec. 17

FINAL PROOF SURVEY UNDER

Application No. 42887 Permit No. 32051
IN NAME OF

WILLIAM SPURLIN

Surveyed July 8 1976, by D. Norby