


# T.I.S., R.I.W., W.M.

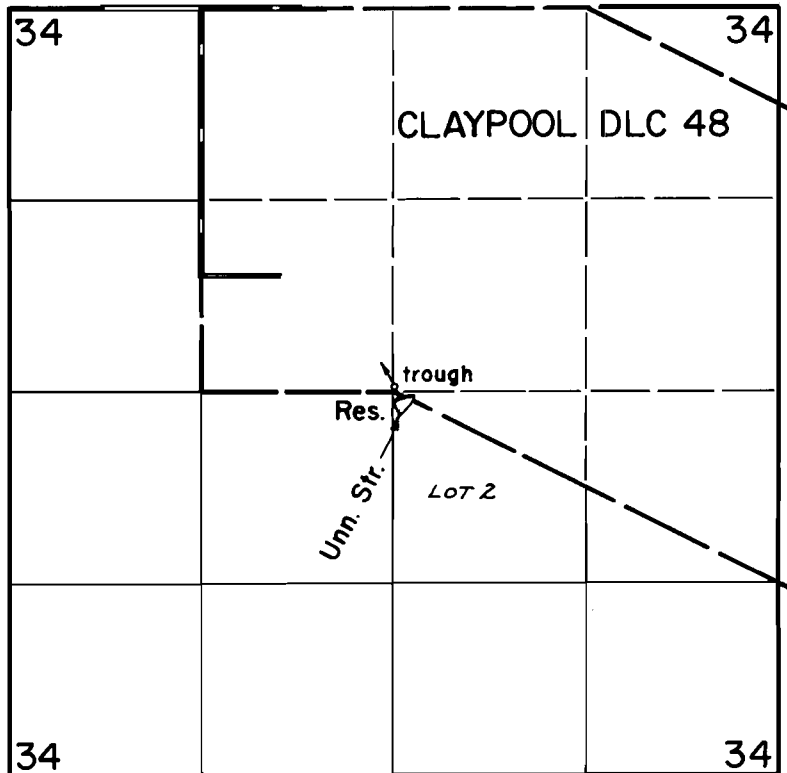

RES. LOC: 2680' S & 1380' E from NW cor. Claypool DLC 48

## FINAL PROOF SURVEY UNDER

R-48230                      R-5864  
Application No. 48231    Permit No. 36221  
IN NAME OF

ROBERT E. AND ROSE MARIE JOHNSON

Surveyed April 2 1976, by D. Norby