App 467 Per. 224

nship 2 N - Range 10 E of W.M.
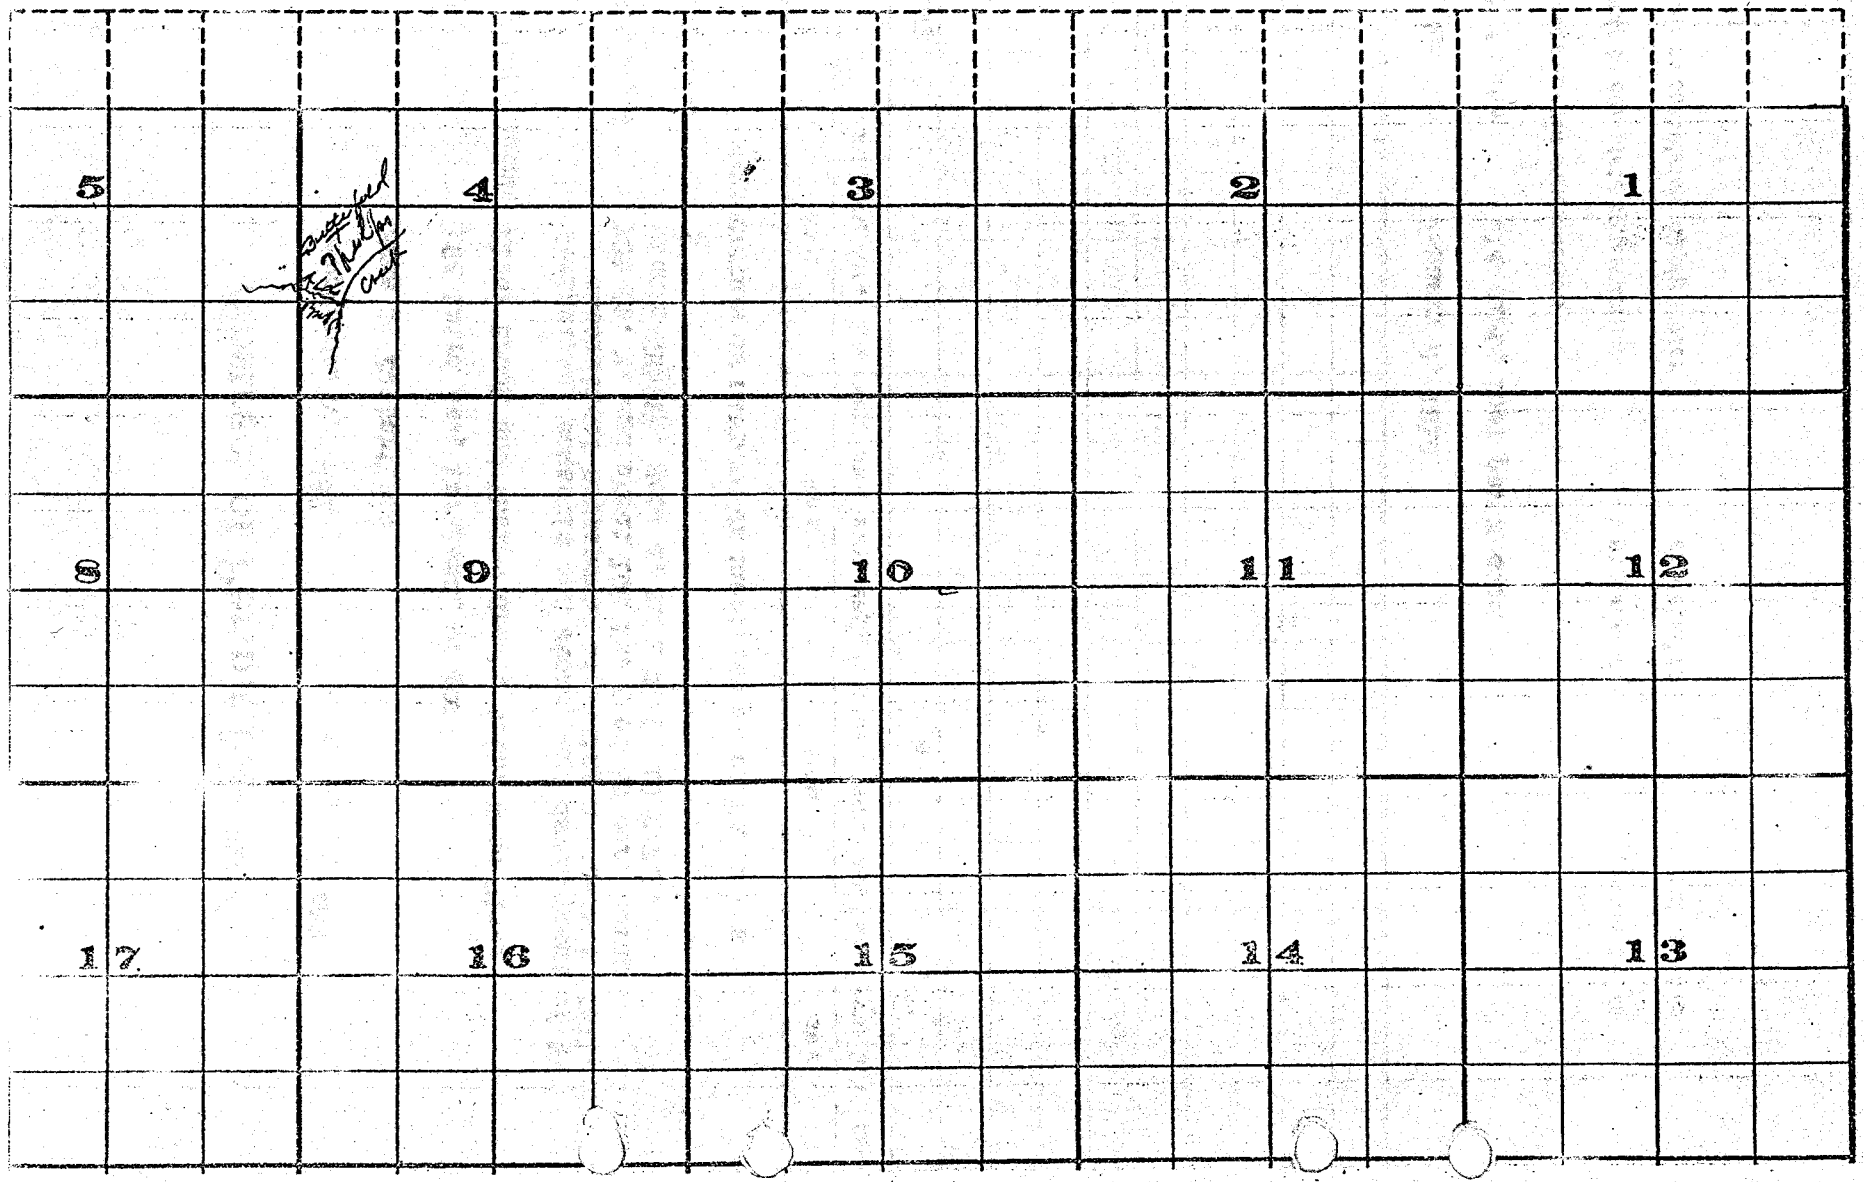
Hood River County Oregon