


T.14S., R.1W., W.M.

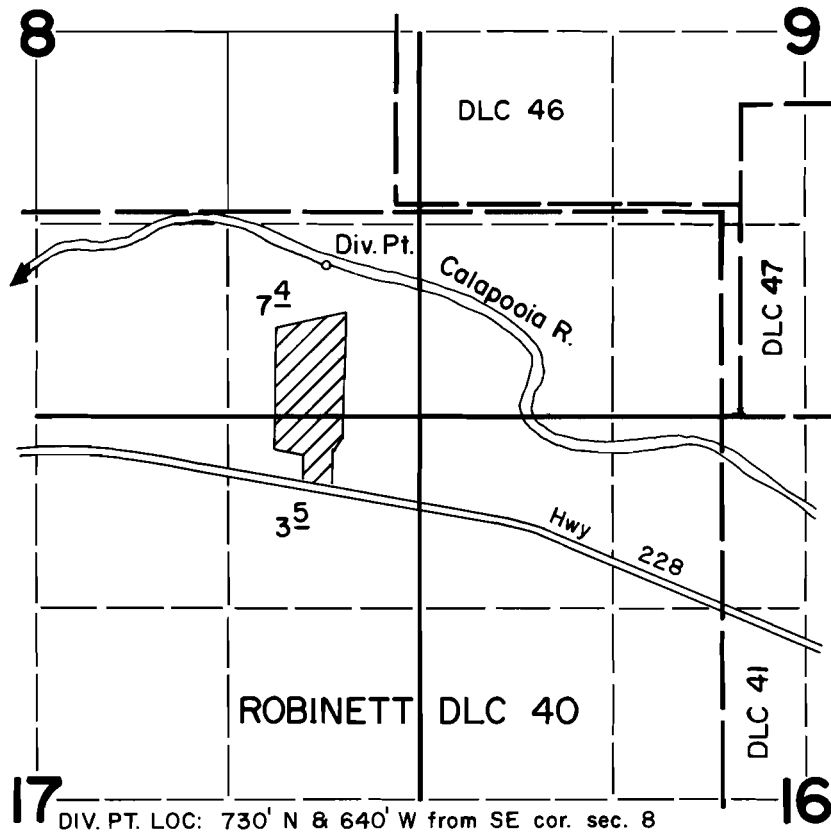

FINAL PROOF SURVEY UNDER

Application No. 50320 Permit No. 37992
IN NAME OF

THOMAS K. & EMMA L. FLANAGAN

Surveyed May 4 1976, by D. Norby