


T.5S.,R.1W.,W.M.

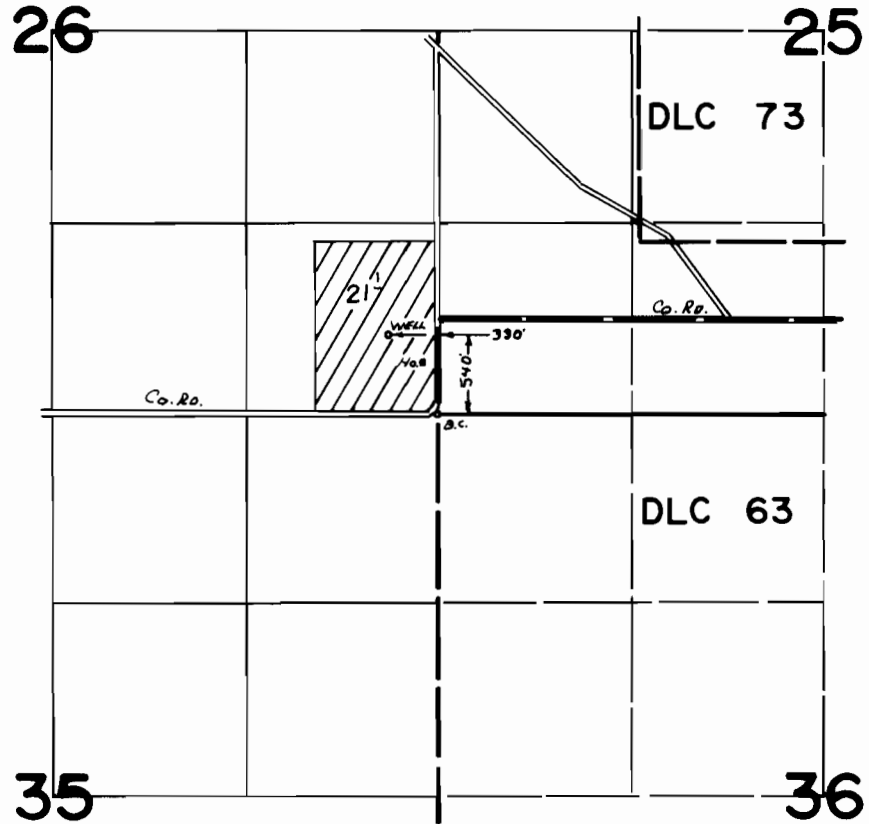

FINAL PROOF SURVEY
UNDER

Application No. G-5924 Permit No. G-5631
IN NAME OF

GRIGORY MELKOMUKOV

Surveyed APRIL 23 1976, by L. TOLL