


# T.6S.,R.3W.,W.M.

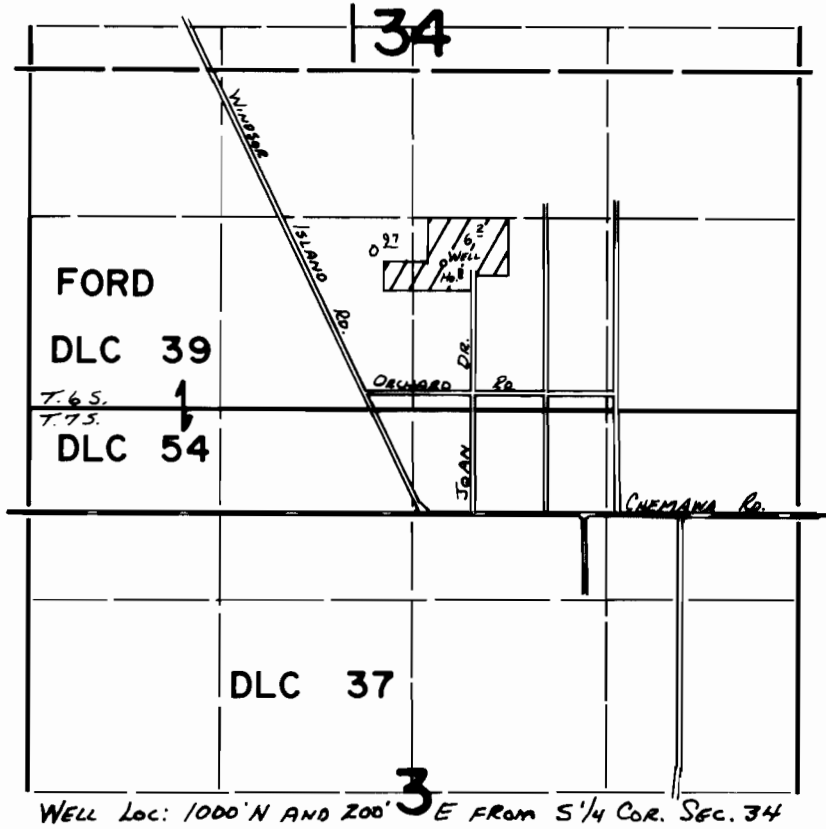

## FINAL PROOF SURVEY UNDER

Application No. G-6273. Permit No. G-5906.  
IN NAME OF

.....ARTHUR A. BINNIE.....

Surveyed *MAY 20 1976*, by *L. TOLL*.....