


# T.4S.,R.1W.,W.M.

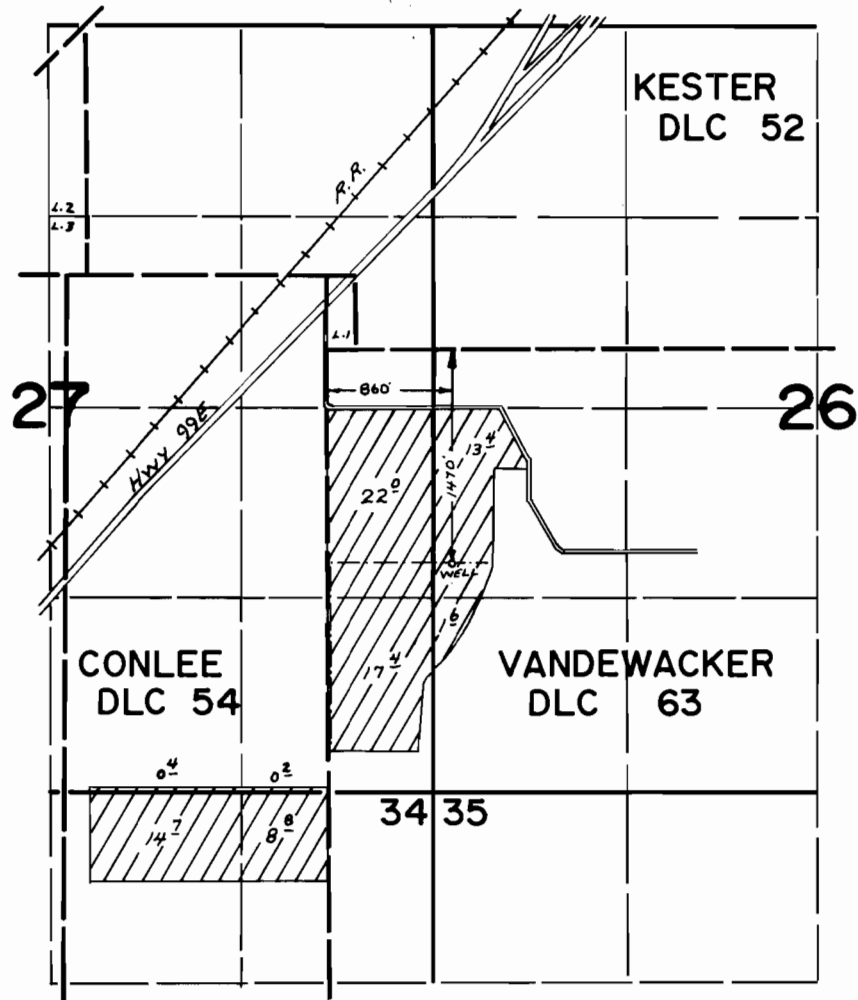

## FINAL PROOF SURVEY UNDER

Application No. G-6406 Permit No. G-5992  
IN NAME OF

STAUFFER BROS.

Surveyed APRIL 20, 1976, by L. TOLL