

G 6101
26908

T. 4N., R. 28E.W. M. - SEC. 17

NW $\frac{1}{4}$ of NE $\frac{1}{4}$


Application No. G 6101

Permit No. G 8229

RECEIVED

AUG 27 1973

STATE ENGINEER
SALEM, OREGON

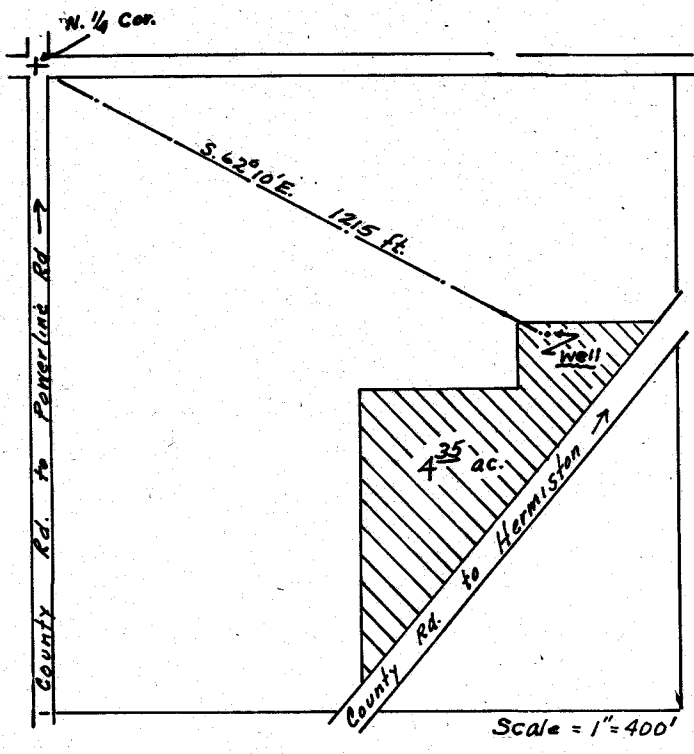

RECEIVED
MAY 1 1973
STATE ENGINEER
SALEM, OREGON

*A map to accompany groundwater application
in the name of John L. King-Hermiston, OR.
97838*