


T.6S.,R.1W.,W.M.

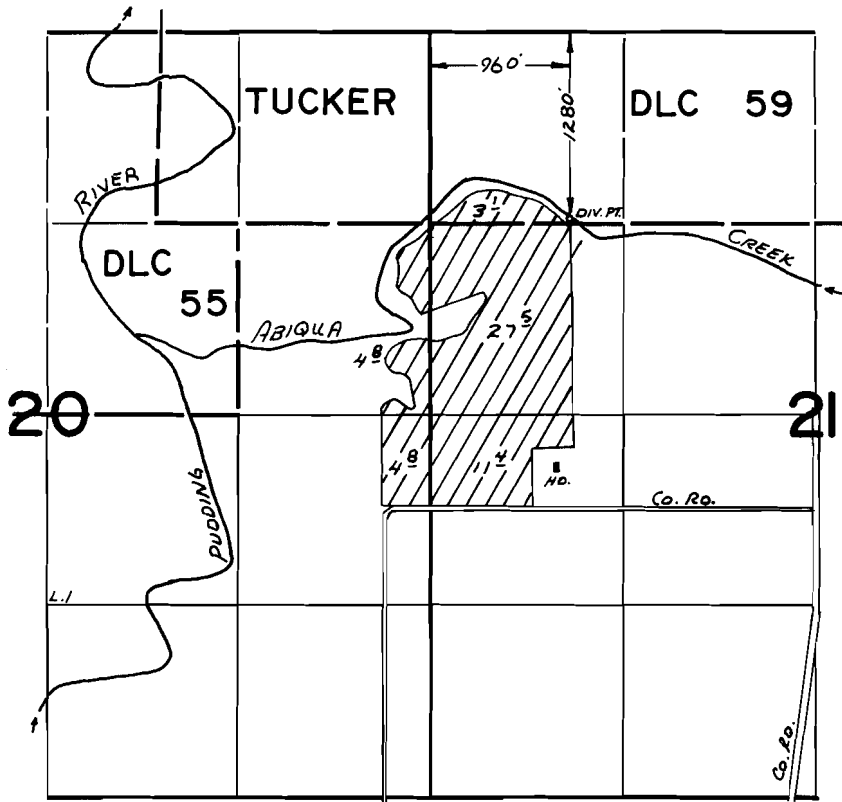

FINAL PROOF SURVEY UNDER

Application No. 50043. Permit No. 37618...
IN NAME OF

..... LEROY BEALS

Surveyed Aug. 11, 1976, by L. Toll