


# T.5S.,R.1W.,W.M.

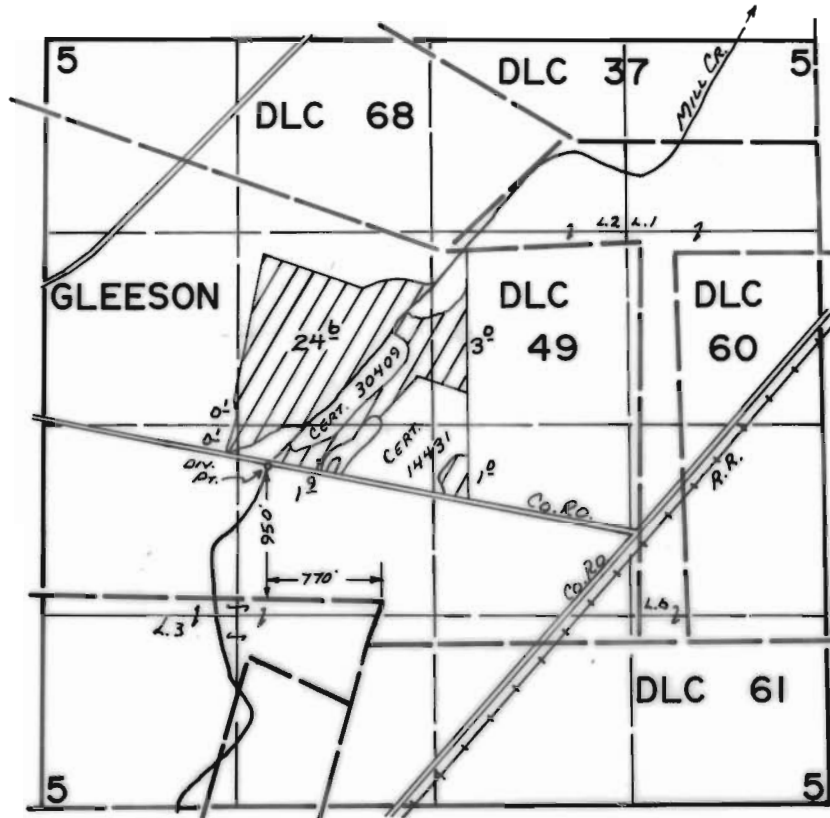

## FINAL PROOF SURVEY UNDER

Application No. 50844 Permit No. 38388  
IN NAME OF

LYNN SIMON

Surveyed APRIL 23 1976, by L. TOLL