


T.8S.R.3W.W.M.

SECTION 5

1" = 200'

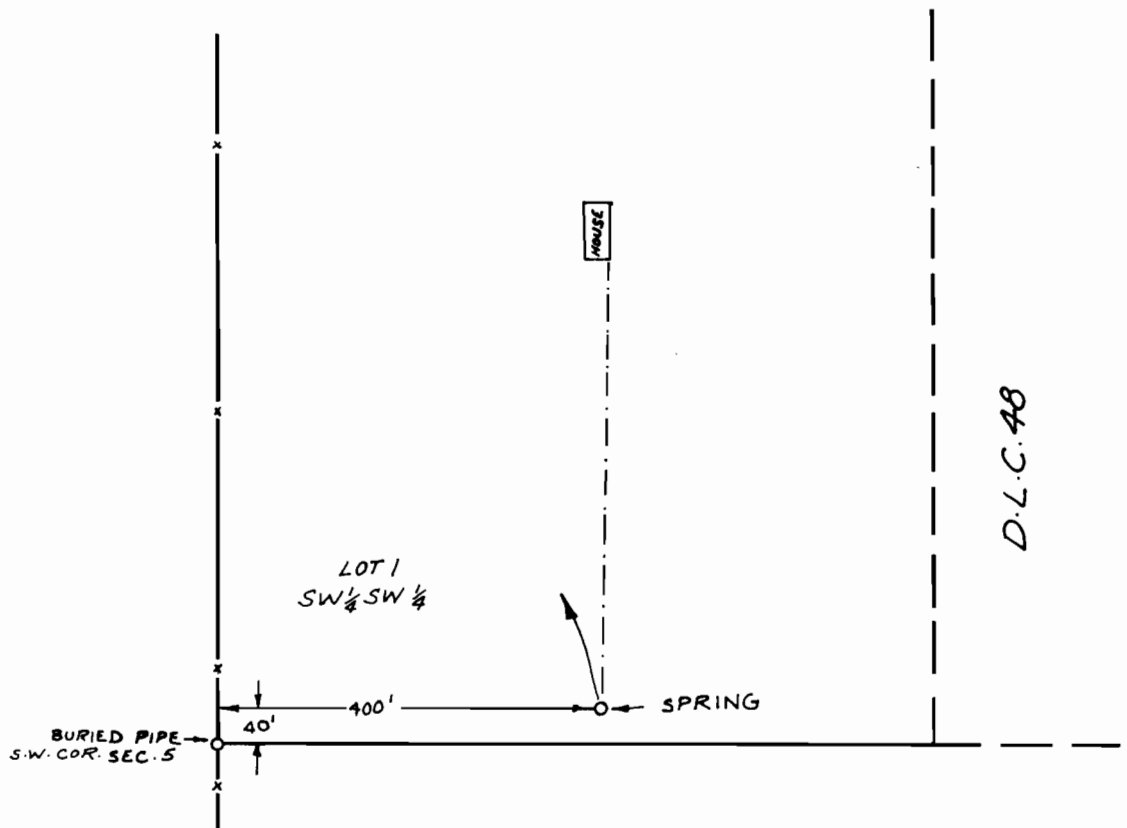

FINAL PROOF SURVEY
UNDER

Application No. 51332 Permit No. 38754
IN NAME OF

LOREN WILCOX

Surveyed AUG. 5, 1976, by R. MUCKEN