


# T.7S.R.1 W.W.M.

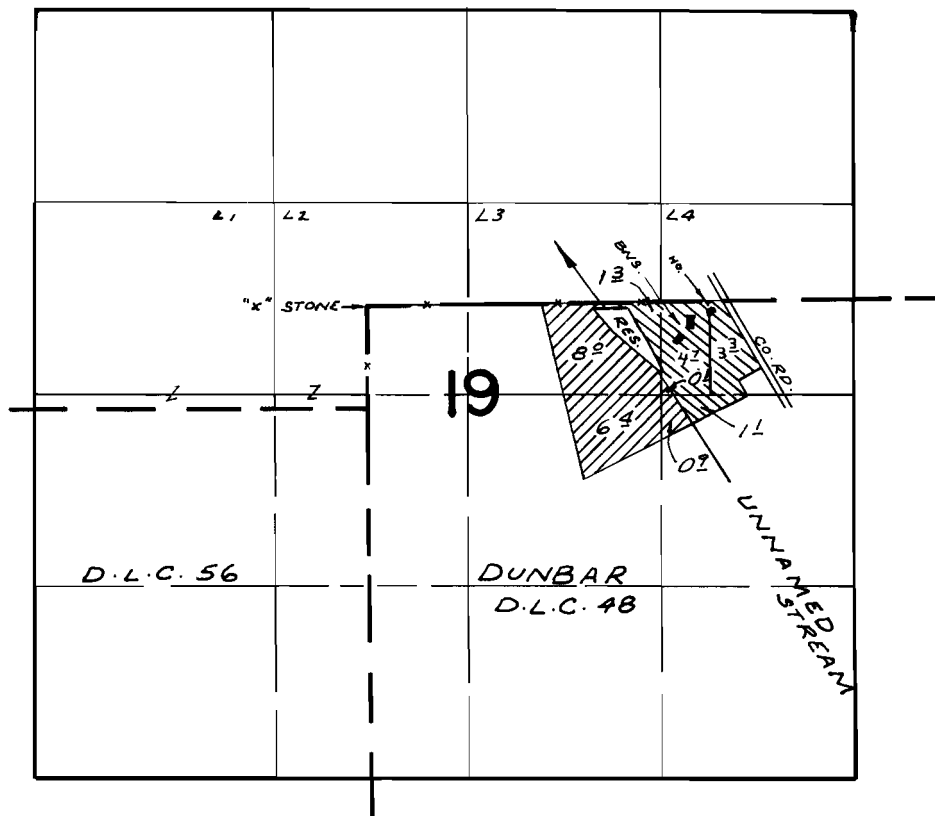

DIV. PT. LOC: 1630'E. & 30'S. FROM N.W. COR. DUNBAR D.L.C. 48

## FINAL PROOF SURVEY

UNDER

51818  
R-40209  
40210

39024  
R-4139  
29819

Application No. 41472 Permit No. 30961  
IN NAME OF

JAMES H. AND EUNICE V. THOMPSON

Surveyed MAY 31, 1972, by R. MUGGEN  
OCT. 8, 1976 L. TOLL