


T. 7 S., R. 5 W., W.M.

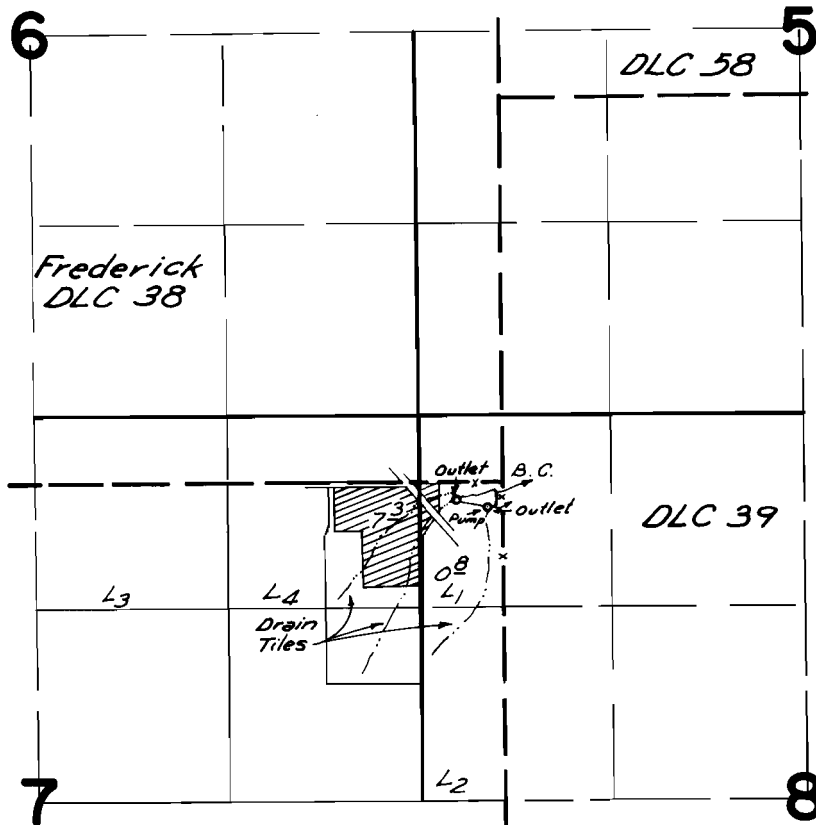

FINAL PROOF SURVEY UNDER

Application No. G-6492 Permit No. G-6110
IN NAME OF

Eugene E. & Mabel R. Villwock

Surveyed May 13, 1976 by L. H. Nunn