


G-5750
46920
46921

T.1S.R.17E.W.M.

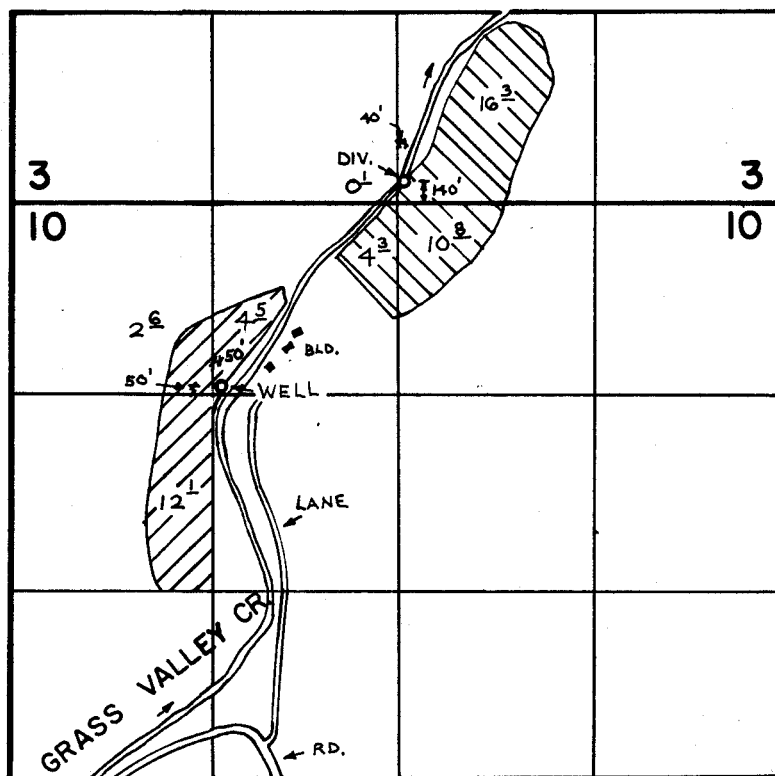

-  PRIMARY FROM CREEK
 PRIMARY FROM WELL & SUPPL. FROM CREEK

FINAL PROOF SURVEY
UNDER

G-6029 G-5750
Application No. 50144 Permit No. 37896
IN NAME OF
CHARLES BURNET

Surveyed July 14 1976, by R. G. Mucken