


P- 37341

46923

46924

46922

T. 2N. R. 18E. W.M.

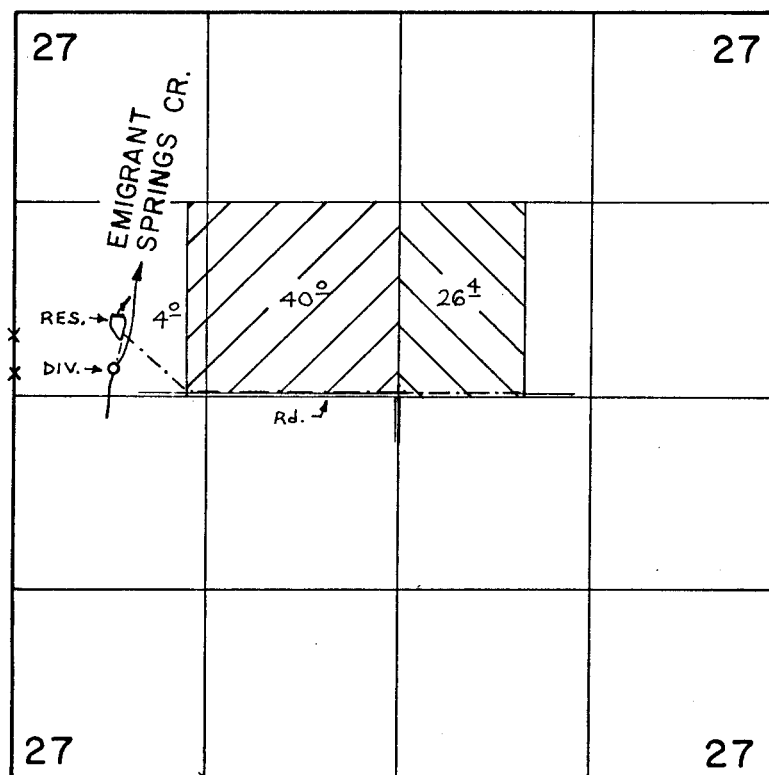

CR. DIV. - 200' N. & 670' E. FROM $\frac{1}{4}$ COR. SEC. 27
RES. DIV. - 560' N. & 700' E. FROM $\frac{1}{4}$ COR. SEC. 27

FINAL PROOF SURVEY

UNDER

53982

40258

R-51804

R-6063

Application No. 51805 Permit No. 37341

IN NAME OF

DEWEY J. THOMAS

Surveyed July 16 1976, by R.G. Mucken.

DHM

1876-Z-1