


T.2S.R.8W.W.M.

LOT 1

N.E. 1/4 N.E. 1/4 SEC. 1

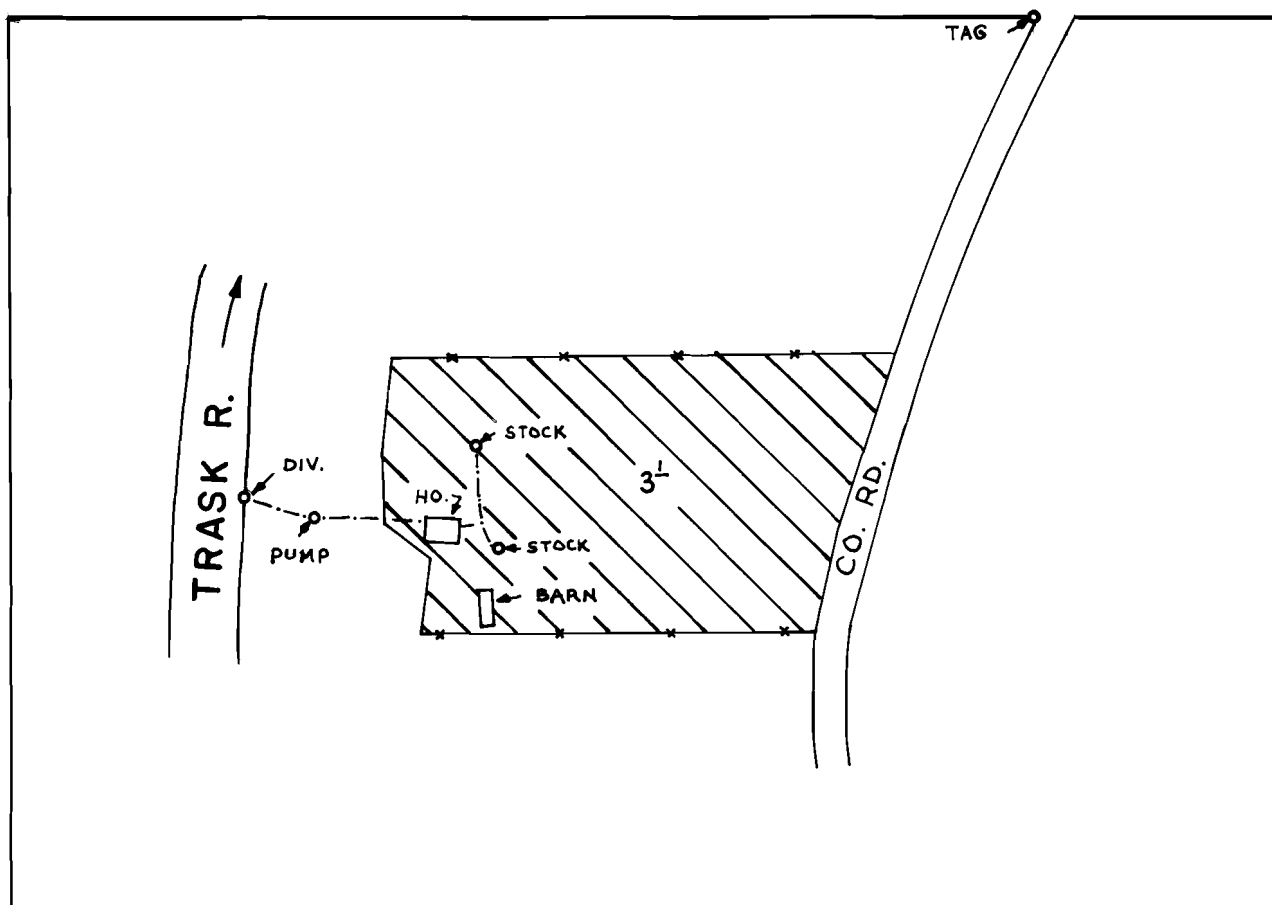

DIV. LOC. - 490' S. & 1080' W. FROM N.E. COR. SEC 1

SCALE: 1" = 200'
FINAL PROOF SURVEY
UNDER

Application No. 50017 Permit No. 37606
IN NAME OF

THEADORA NORWOOD

Surveyed July 27 1976, by R. G. Mucken