


# T.4-5S., R.9W., W.M.

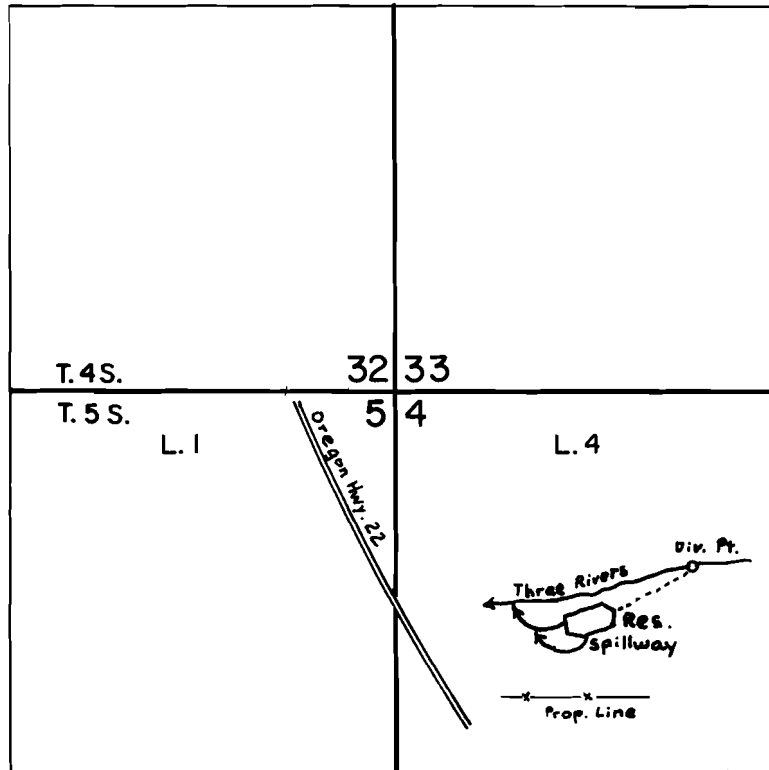

Div. Pt. Located: 600' S., 1020' E.; Dam Located: 800' S., 600' E., both from the N.W. cor. of Sec. 4

Scale: 1" = 660'

## FINAL PROOF SURVEY UNDER

51845                      39145  
Application No. R-51844 Permit No. R-6270  
IN NAME OF

OREGON DEPARTMENT OF FISH AND WILDLIFE

Surveyed JUNE 21, 1976, by D. NORBY