


T.2N.R.10W.W.M.

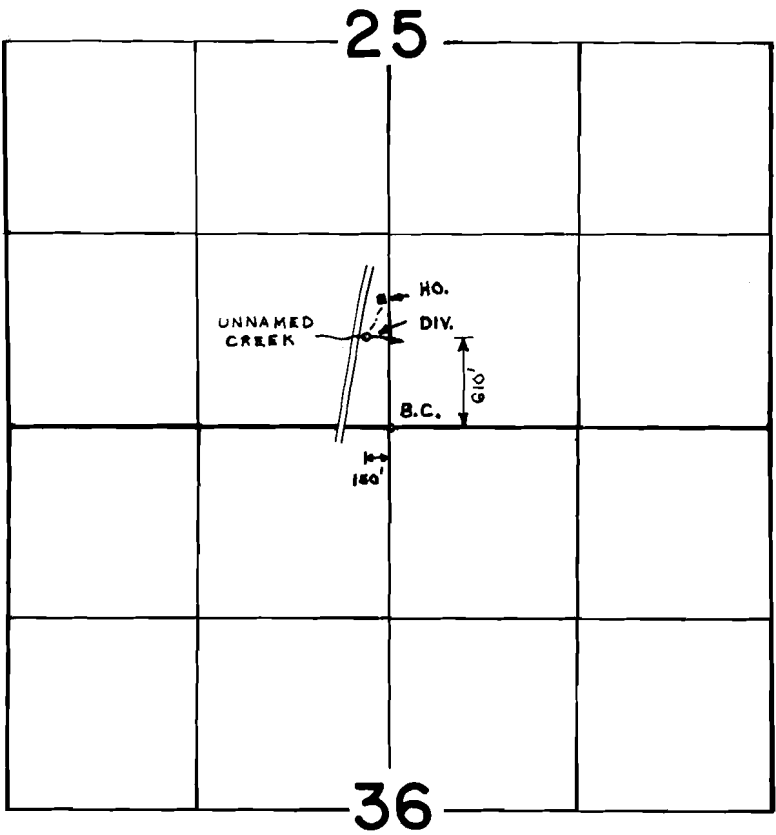

FINAL PROOF SURVEY
UNDER

Application No. 53646 Permit No. 39380
IN NAME OF
WALTER F. & PATRICIA A. STABEN
Surveyed July 30 1976, by R.G. Mucken