


G 5794
46931

T.4N.,R.34E.,W.M.

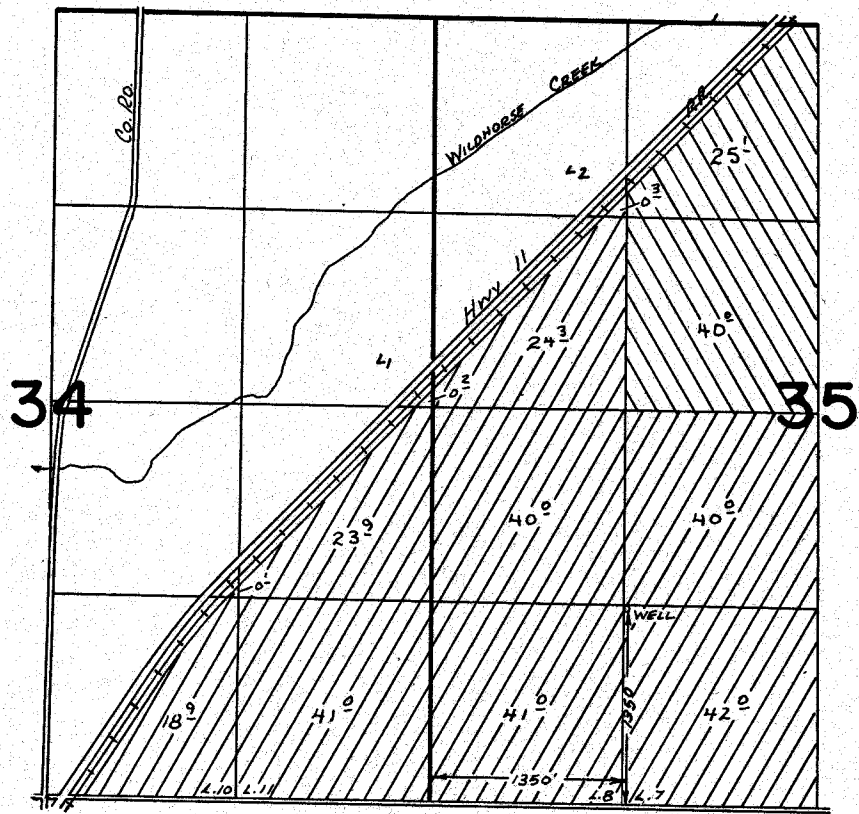

FINAL PROOF SURVEY UNDER

Application No. G-6120 Permit No. G-5794
IN NAME OF

B. L. DAVIS RANCH, INC.

Surveyed APRIL 9, 1916, by L. T. GALT