



G 5794
46931

T.4N.,R.34E.,W.M.

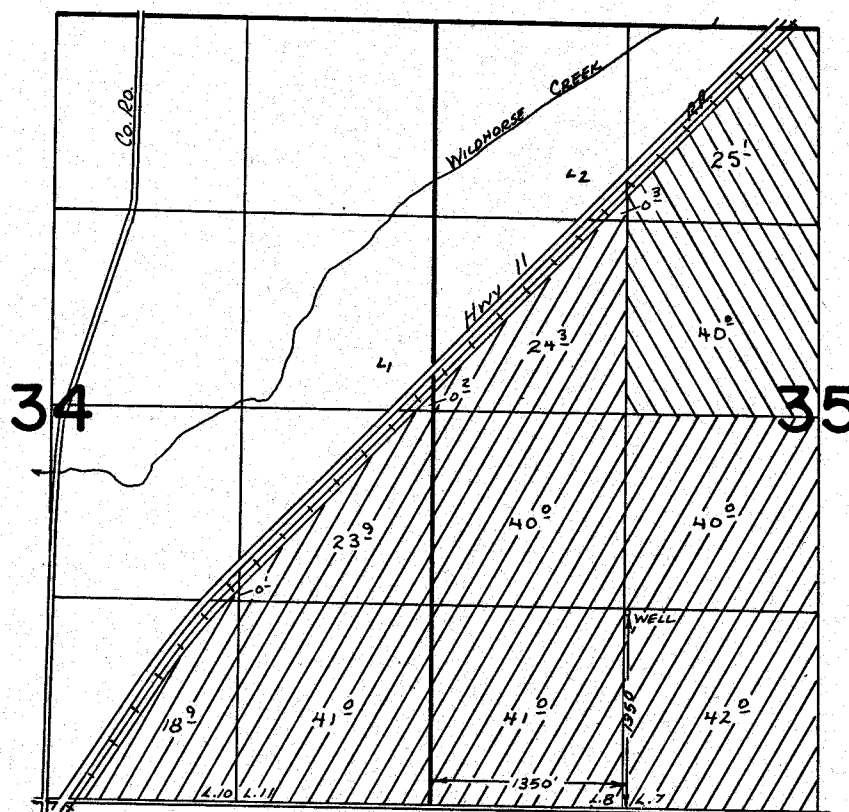

FINAL PROOF SURVEY UNDER

G-6120 G-5794
Application No. G-6121 Permit No. G-5795 
IN NAME OF

B. L. DAVIS RANCH, INC.

Surveyed APRIL 9 1976, by L. TOLL