


T. 4 N., R. 28 E., W.M.

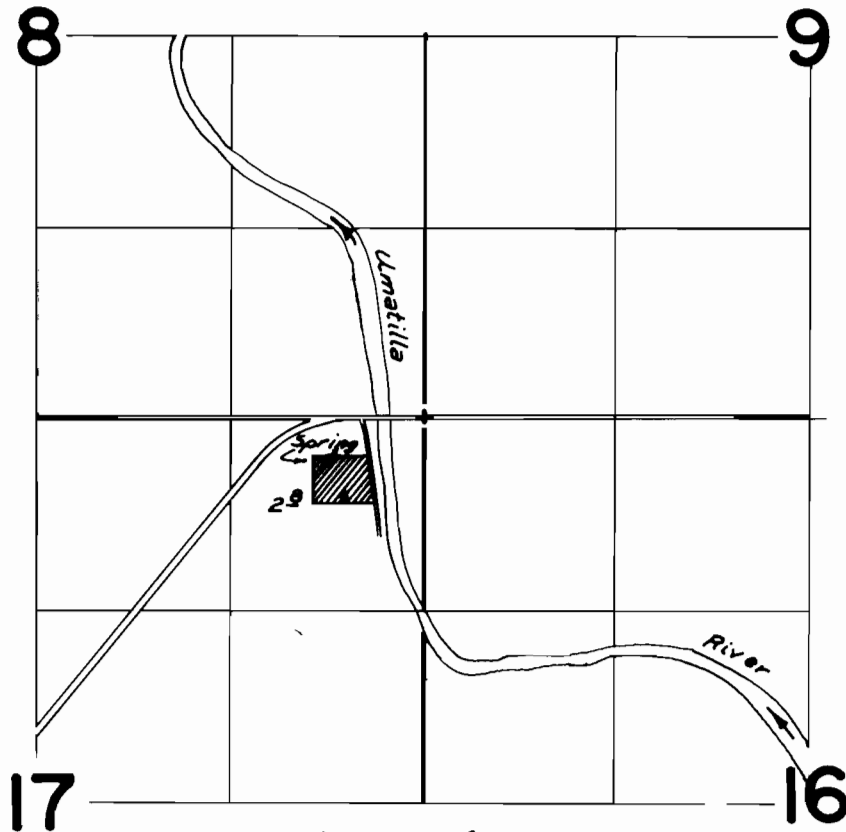

Spring Loc.: 280' S & 660' W from NE Cor. Sec. 17

FINAL PROOF SURVEY UNDER

Application No. 52020 Permit No. 39209
IN NAME OF

Frank & Norma Lerfald, Jr.

Surveyed July 29, 1976 by L. H. Nunn