T.7&8S.R.19E.W.M.

FEB 2 0 1978
WATER RESOURCES DEPT.
SALEM, OREGON

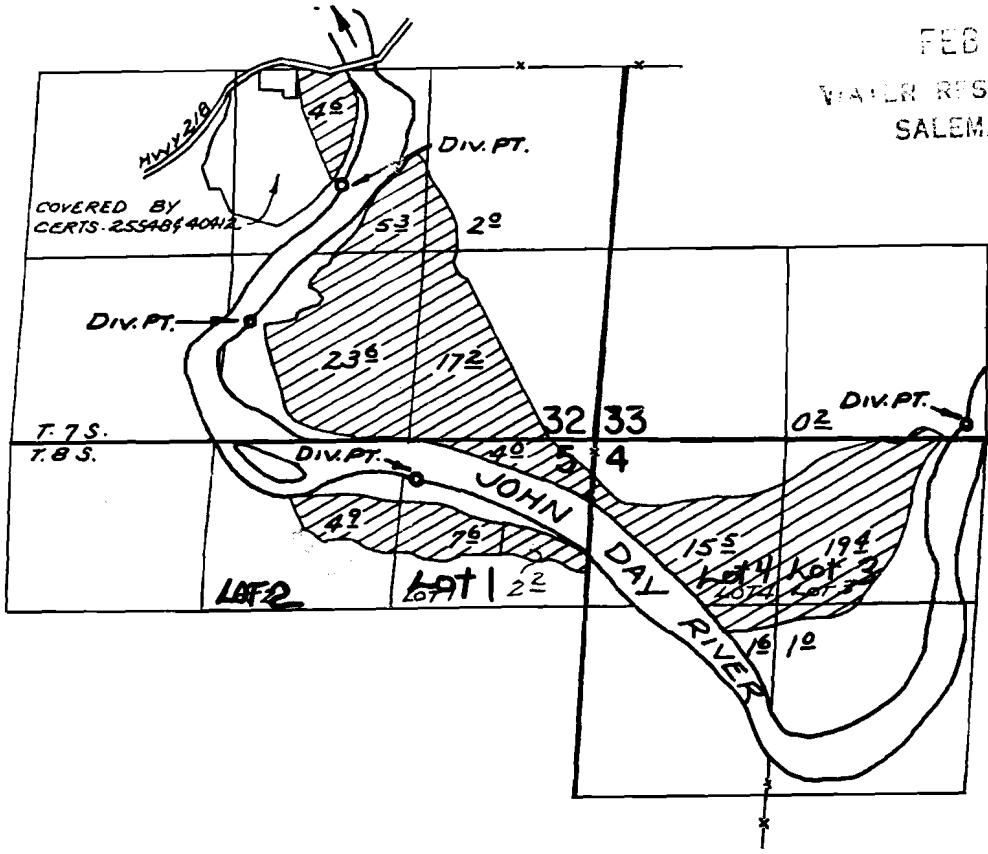

DIV. PT. LOC:- 1730' N. & 1700' W.; 820' N. & 2350' W.; 100' N. & 2530' E.; 270' S. & 1230' W.; all from S.E. Cor. Sec. 32

FINAL PROOF SURVEY
UNDER

Application No. 44399 Permit No. 33295
IN NAME OF

JAMES G. & SHIRLEE DILLARD PERKINS

Surveyed JULY 16 1974, by R. MUCKEN

Application No. 53939
Permit No. 40210