


T.5S., R.5W., W.M.

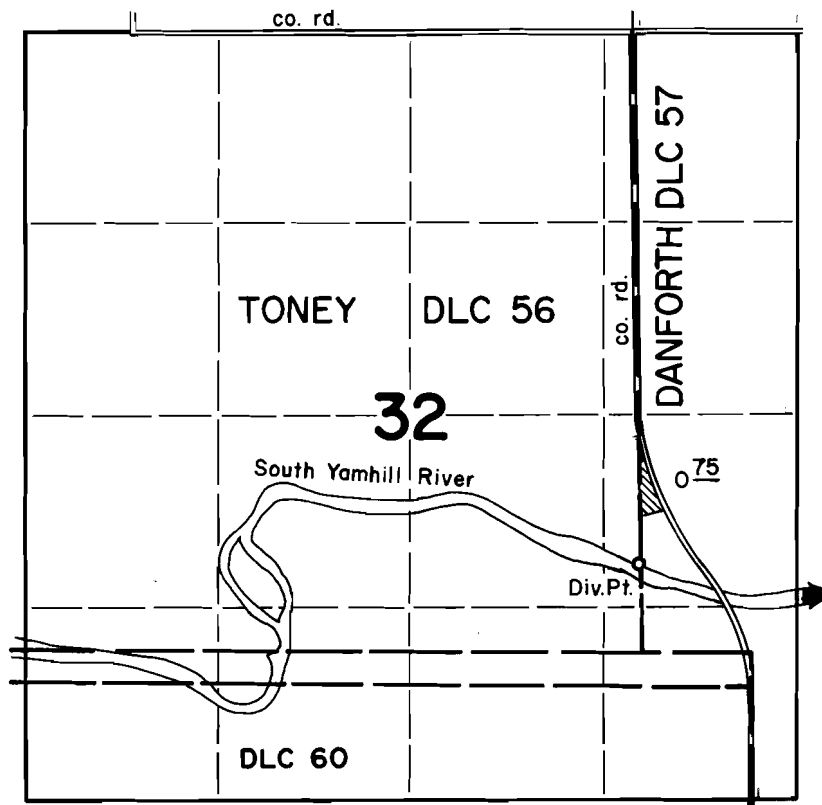

DIV. PT. LOC: 610' N from SE cor. Toney DLC 56

FINAL PROOF SURVEY UNDER

Application No. 50394 Permit No. 38035
IN NAME OF

A. C. & PEARL CAMP

Surveyed July 7 1976, by L. H. Nunn