


# T.5 S., R.7 W., W.M.

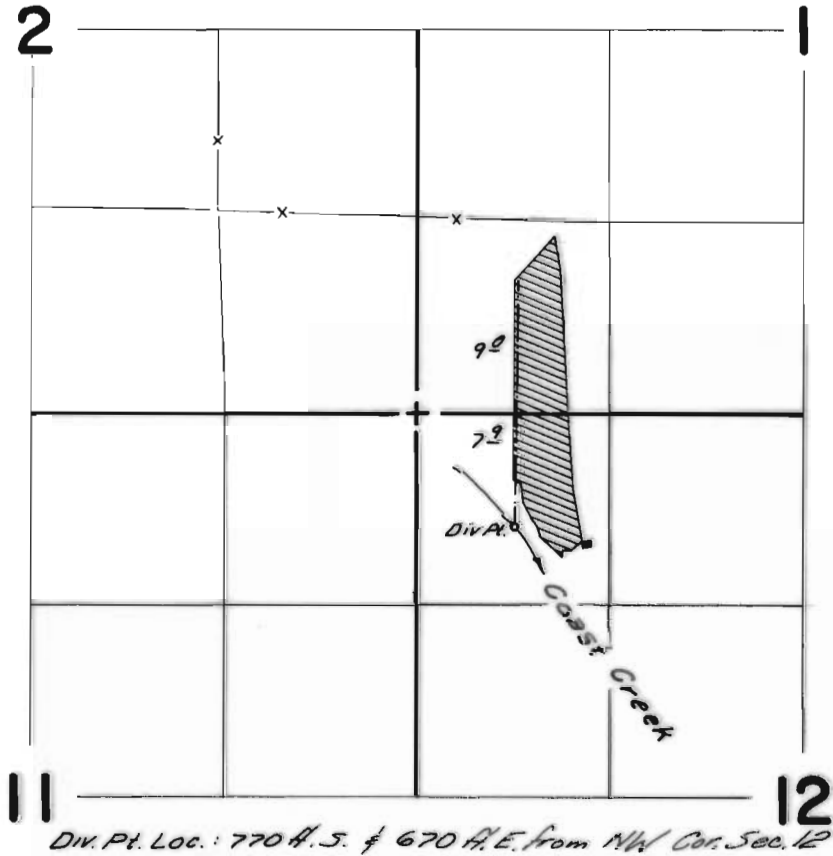

Div. Pt. Loc.: 770 ft. S. & 670 ft. E. from NW Cor. Sec. 12

## FINAL PROOF SURVEY UNDER

Application No. 50842 Permit No. 37761  
IN NAME OF

William O. Payne

Surveyed Sept. 9, 1976, by L. H. Nunn