


T.5S., R.5W., W.M.

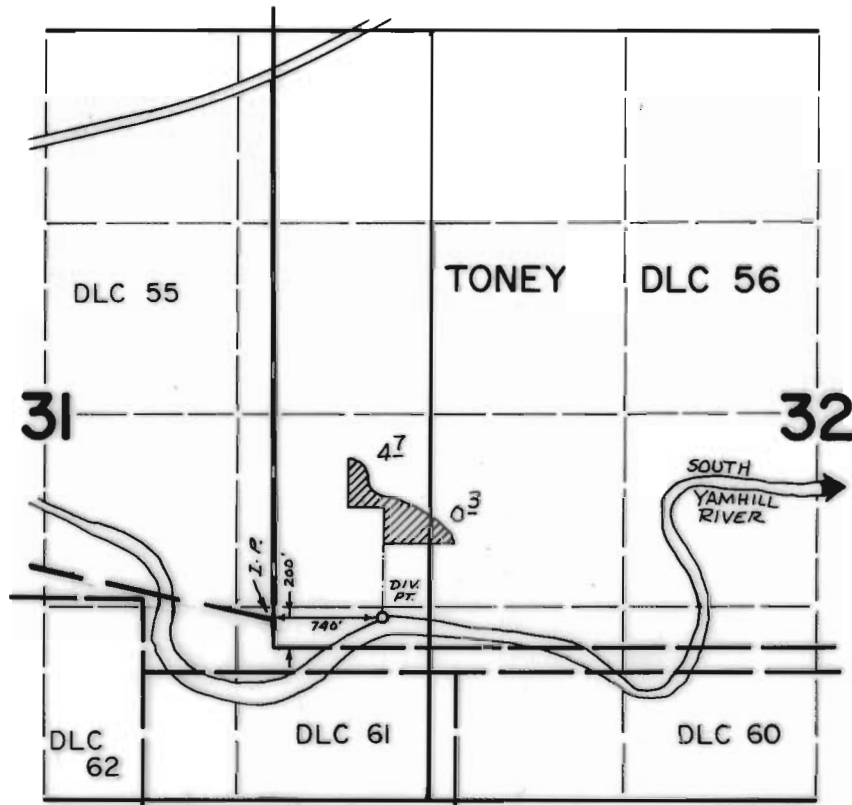

FINAL PROOF SURVEY UNDER

Application No. 51594 Permit No. 37764
IN NAME OF

J. P. WEPSTER

Surveyed July 7 1976, by L.H. Nunn