


T.5S. R.7W. W.M.

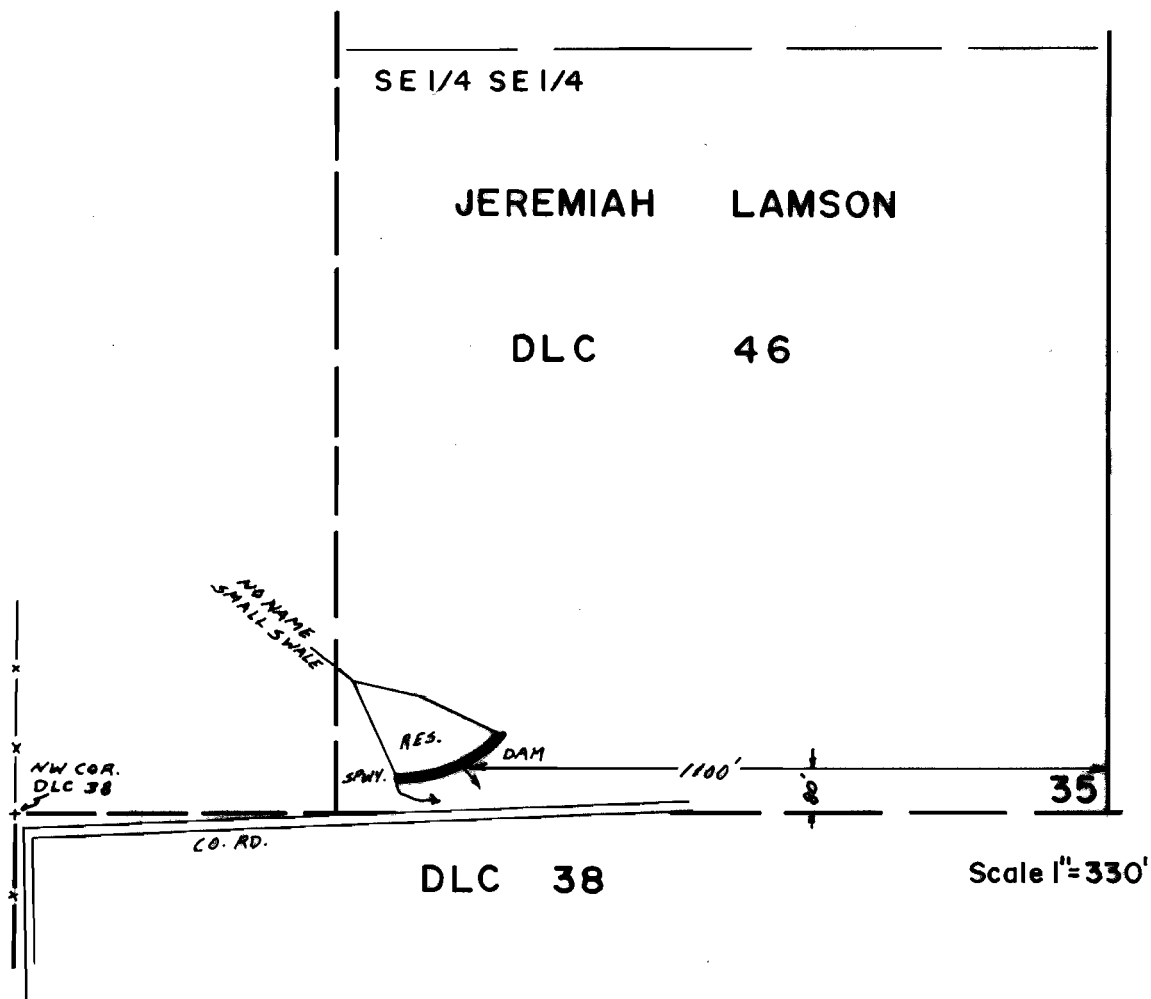

FINAL PROOF SURVEY UNDER

Application No. R-52914 Permit No. R-6393.
IN NAME OF

.....IVAN DENT.....

Surveyed Aug. 6, 1976, by D. NORBY.....