


T. 5 S., R. 6 W., W.M.

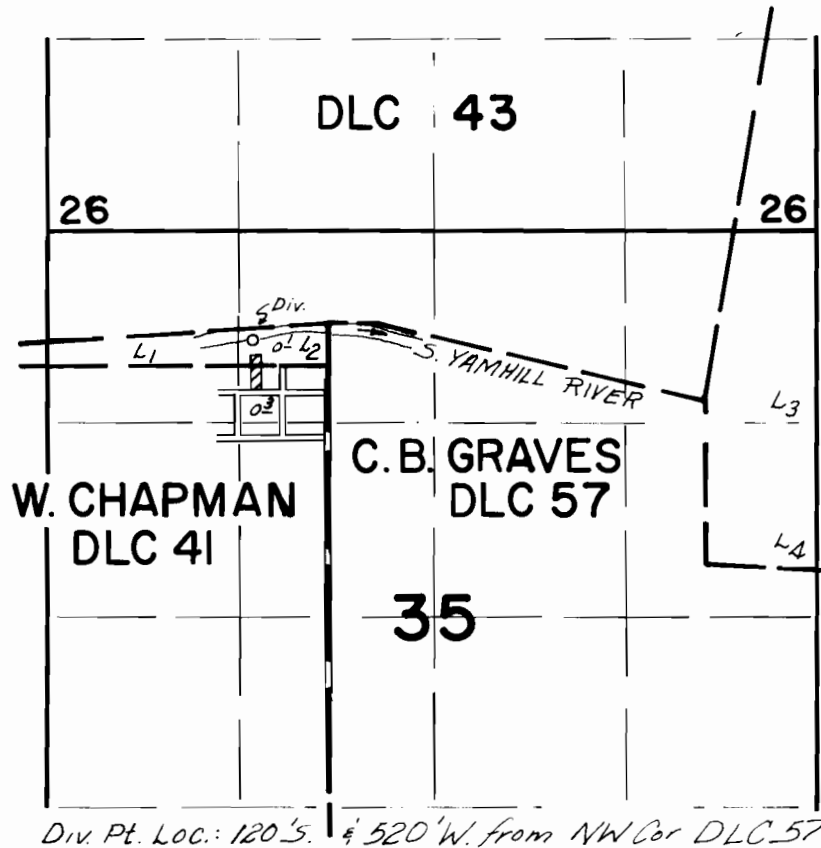

FINAL PROOF SURVEY UNDER

Application No. 52947 Permit No. 39974
IN NAME OF

LEONA REIMER

Surveyed AUG. 4, 1976, by D. NORBY