


T.5S., R.6W., W.M.

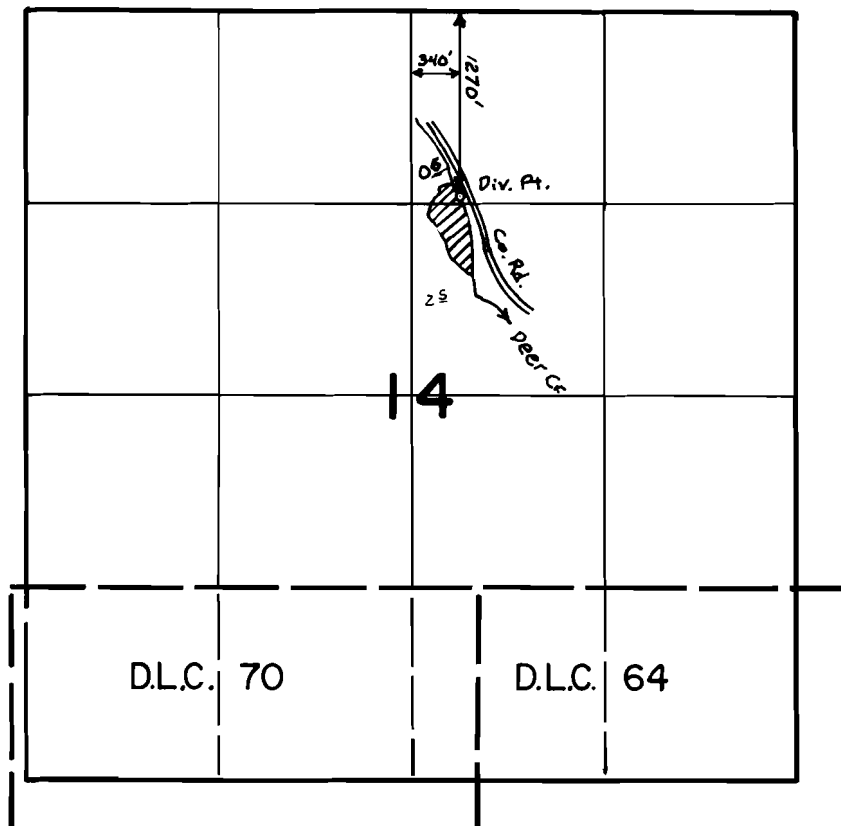

FINAL PROOF SURVEY
UNDER

Application No. 53991 Permit No. 40262
IN NAME OF

EVERETT DE HART

Surveyed AUG. 3 1976, by D. NORBY