


T. 5 S. R. 5 W. W. M.

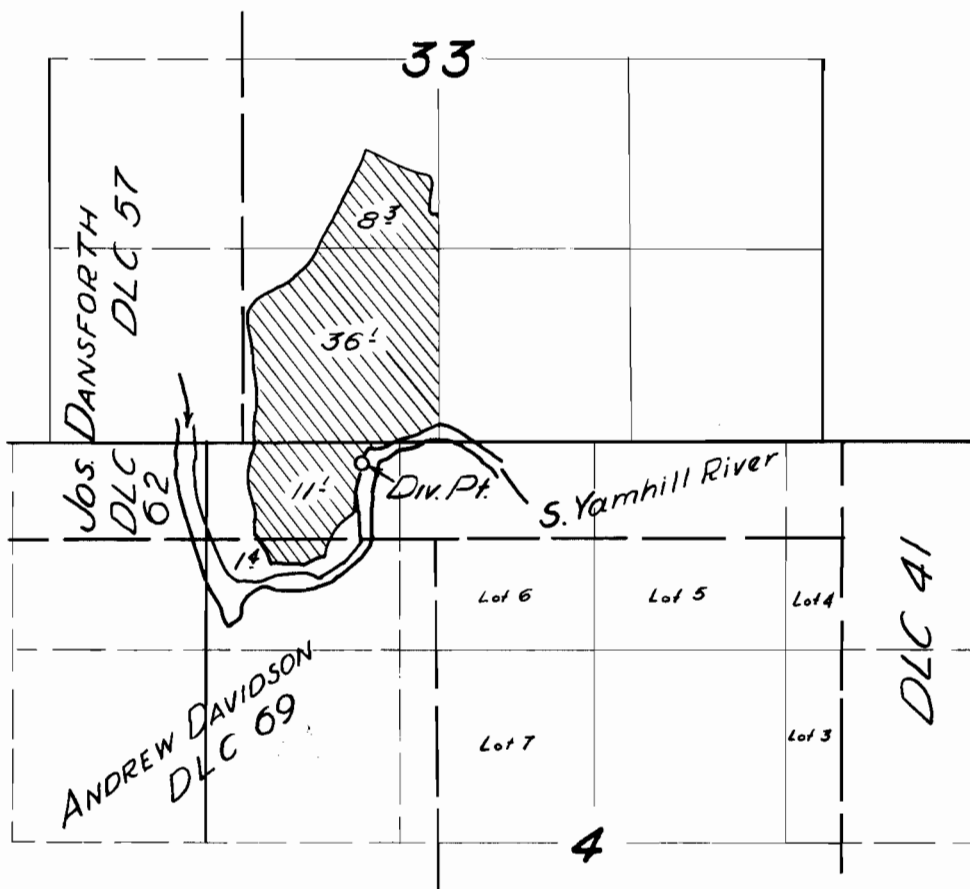

FINAL PROOF SURVEY  
UNDER

Application No. 26553 Permit No. 21008

IN NAME OF

RHODA C. SMITH

Surveyed 28 Mar. 1956 by [Signature]