


T.4S.R.4W.W.M.

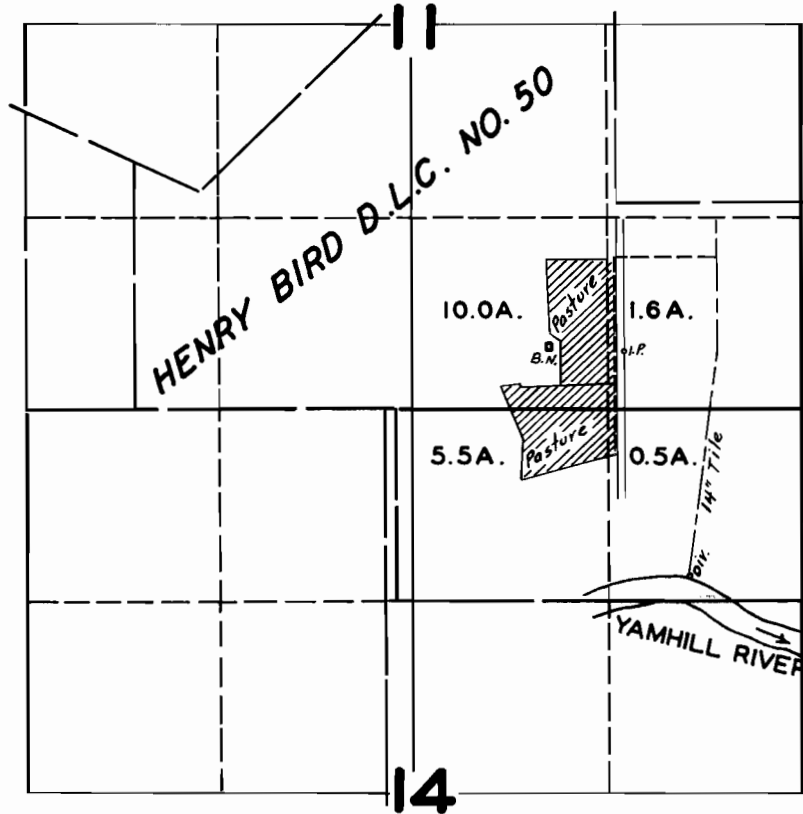

FINAL PROOF SURVEY UNDER

Application No. 19911 Permit No. 15487.....
IN NAME OF

W. D. WARMINGTON

Surveyed MAR. 27 1947, by JAS. E. BUNNELL