


T.5S.,R.1E.,W.M.

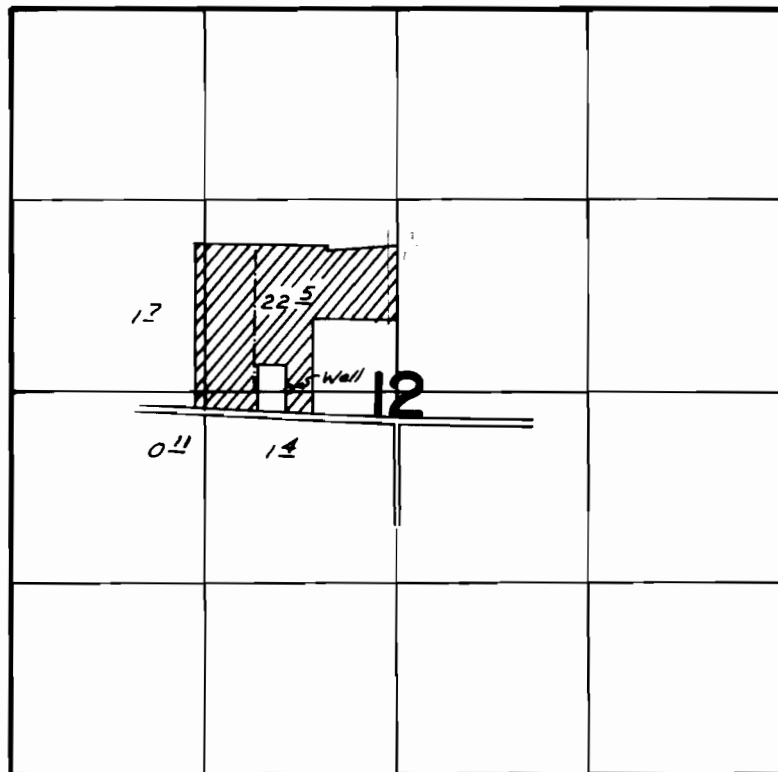

Well Loc.: 20' N. & 760' W. from ctr. Sec. 12

FINAL PROOF SURVEY
UNDER

Application No. G-6248 Permit No. G-5890
IN NAME OF

David D. & Nora L. DeFrates

Surveyed Aug 19, 1977, by B. Barwin

DFK-3LL-34 *LCB*