


T.4N R.1&2W. W.M.

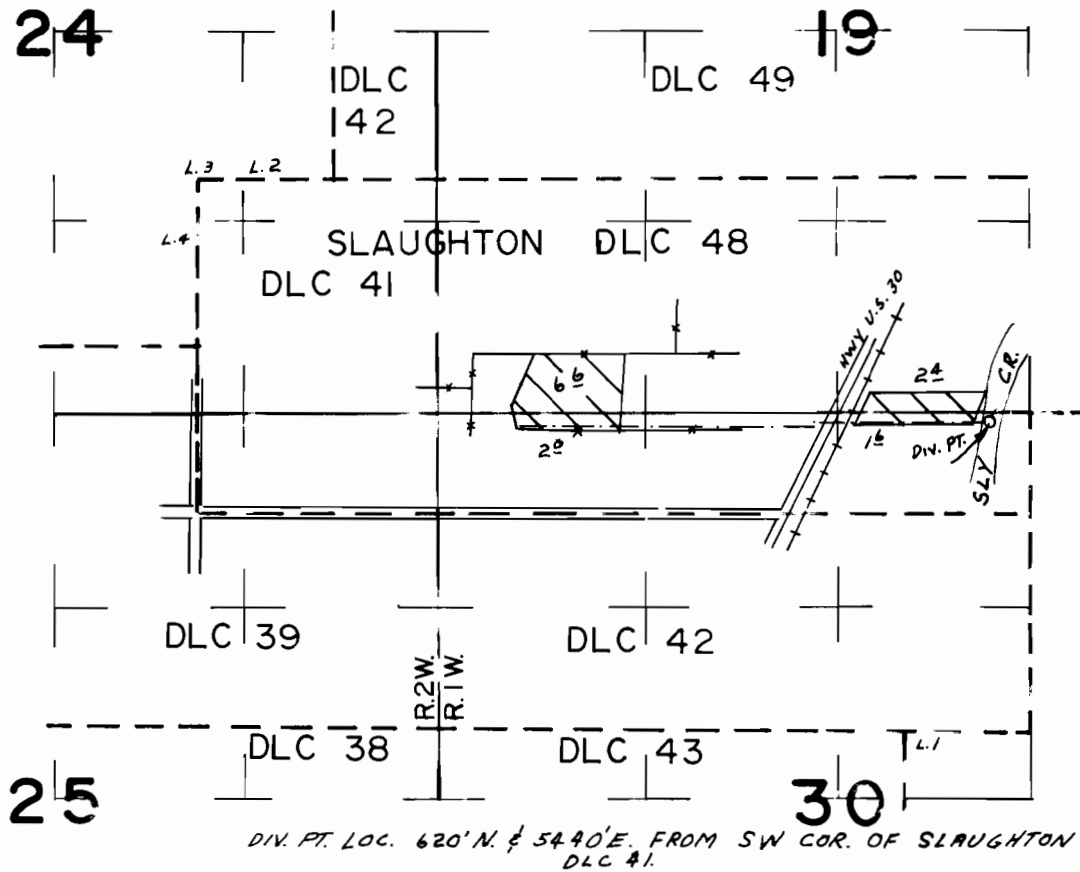

FINAL PROOF SURVEY UNDER

Application No. 51866..... Permit No. 37765....
IN NAME OF

EARL J. & THOMASINA M. McCOY.....

Surveyed MAY 28, 1976., by L.H. NUNN.....