


T.23S.R.31E.W.M.

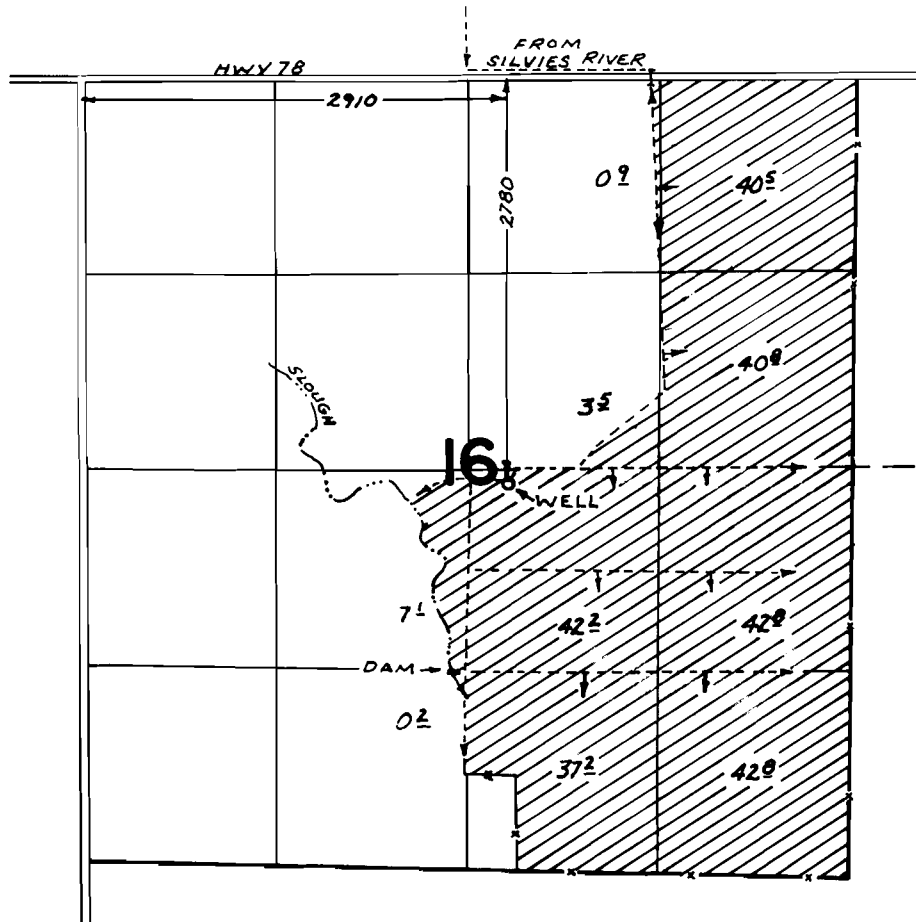

FINAL PROOF SURVEY UNDER

Application No. *G-5214* Permit No. *G-5077*
IN NAME OF

SAM &/OR ARLICE GUNDERSON

Surveyed *AUG. 12, 1976*, by *R. MUCKEN*