


G-5762
46977
T9497
T8484
T10002

T.25S.R.14E.W.M.

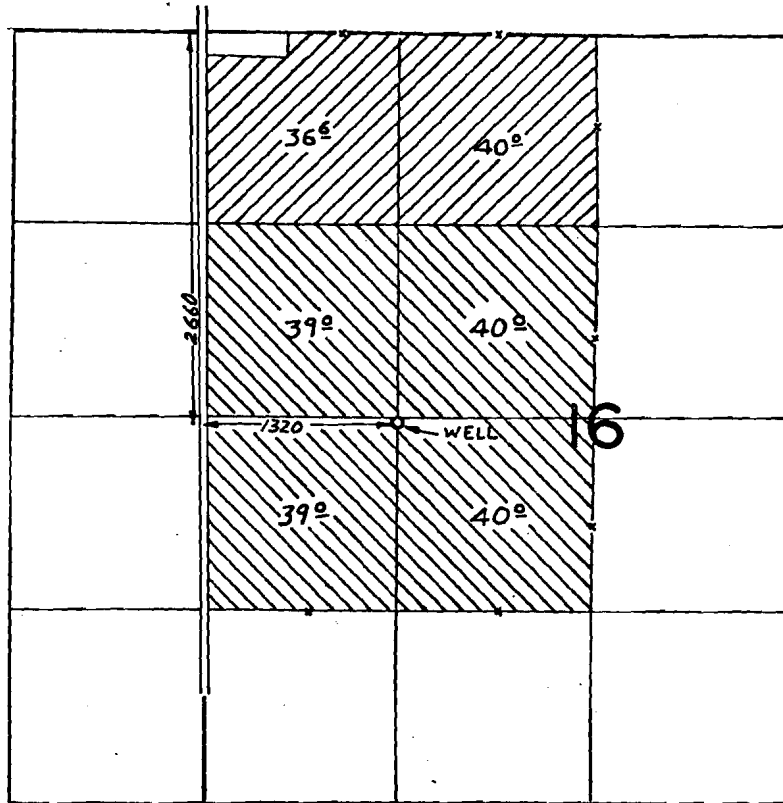

FINAL PROOF SURVEY
UNDER

Application No. *G-6075* Permit No. *G-5762*
G-7358 *G-6812*
IN NAME OF



.....*JACK E. CAMPBELL*.....

Surveyed *OCT. 28, 1976*, by *R. MUCKEN*