

G-6812


46980

T8484

T9497

T10002

T.25S.R.14E.W.M.

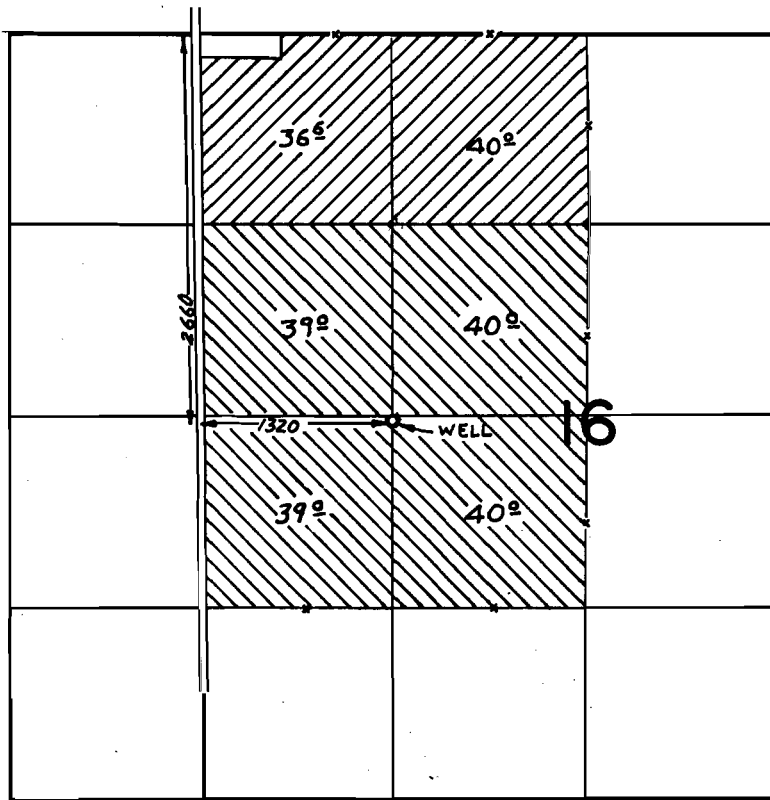

FINAL PROOF SURVEY UNDER

Application No. *G-6075* Permit No. *G-5762*
G-2158 *G-6812*
 IN NAME OF



.....*JACK E. CAMPBELL*.....

Surveyed *OCT. 28, 1976.* by *R. MUCKEN*